

STATE OF KANSAS  
STATE CORPORATION COMMISSION


Form CP-4

Give All Information Completely  
Make Required Affidavit  
Mail or Deliver Report to:  
Conservation Division  
State Corporation Commission  
212 No. Market  
Wichita, Kansas

WELL PLUGGING RECORD

Meade County, Sec. 4 Twp. 34 Rge. 27 (E) W (W)

Location as "NE/CNW/SW" or footage from lines C/SW  
Lease Owner Horizon Oil & Gas Co.  
Lease Name D. Davis "A" Well No. 1-4  
Office Address P. O. Box 7, Spearman, Texas 79081  
Character of Well (completed as Oil, Gas or Dry Hole) Gas  
Date well completed 1-7-65 19  
Application for plugging filed Verbal 11-7-84 19  
Application for plugging approved Verbal 11-7-84 19  
Plugging commenced 12-6-84 19  
Plugging completed 12-6-84 19  
Reason for abandonment of well or producing formation Uneconomical

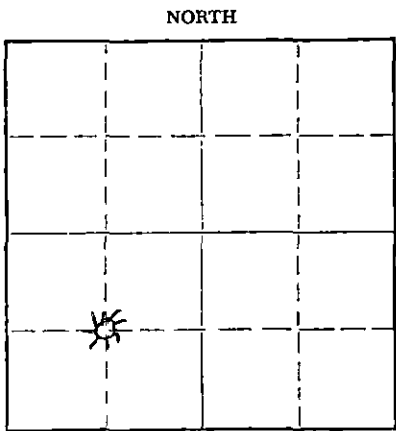

Locate well correctly on above Section Plat

If a producing well is abandoned, date of last production May, 1979 19  
Was permission obtained from the Conservation Division or its agents before plugging was commenced? Yes

Name of Conservation Agent who supervised plugging of this well Paul Luthi  
Producing formation Mississippian Depth to top 5994 Bottom 6006 Total Depth of Well 6090 Feet

Show depth and thickness of all water, oil and gas formations.

OIL, GAS OR WATER RECORDS

CASING RECORD

FORMATION	CONTENT	FROM	TO	SIZE	PUT IN	PULLED OUT
Mississippian	Gas	5994	6006	2 7/8"	6090'	1925'

Describe in detail the manner in which the well was plugged, indicating where the mud fluid was placed and the method or methods used in introducing it into the hole. If cement or other plugs were used, state the character of same and depth placed, from feet to feet for each plug set.

1 sack Hulls and 10 sacks class "H" cement from 5700' to 6006'  
Shot 2 7/8" casing at 1925' - 35 sacks of class "H" at 1890' - 40 sacks class "H" at 1380' - 30 sacks of class "H" at 660' - 10 sacks of class "H" from 0 to 40'.  
Cut off 8-5/8" and welded plate on

RECEIVED  
STATE CORPORATION COMMISSION  
DEC 17 1984  
CONSERVATION DIVISION  
WICHITA, KANSAS

(If additional description is necessary, use BACK of this sheet)  
Name of Plugging Contractor The Western Company  
Address Perryton, Texas 79070

STATE OF Texas COUNTY OF Hansford, ss.

Curtis Covington (employee of owner) or (owner or operator) of the above-described well, being first duly sworn on oath, says: That I have knowledge of the facts, statements, and matters herein contained and the log of the above-described well as filed and that the same are true and correct. So help me God.

(Signature) Curtis F. Covington  
P. O. Box 7, Spearman, Texas 79081  
(Address)

SUBSCRIBED AND SWORN TO before me this 12th day of December, 19 84

[Signature]  
Notary Public.

My commission expires 5-31-85