


STATE OF KANSAS
STATE CORPORATION COMMISSION
CONSERVATION DIVISION
P. O. BOX 17027
WICHITA, KANSAS 67217

FORM CP-4

WELL PLUGGING RECORD

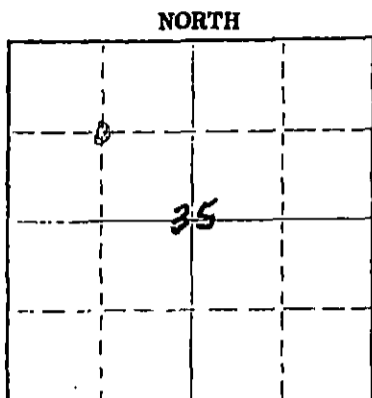

Locate well correctly on above Section Plat

Meade County. Sec. 35 Twp 34S Rge. 26 (E) (W) X
Location as "NE/CNW/SE/SW" or footage from lines. APP. C NW/4
Lease Owner The Heading Company
Lease Name Walker Well No. 1
Office Address 2820 Liberty Tower, Oklahoma City, Okla. 73102
Character of Well (completed as Oil, Gas or Dry Hole) Gas
Date well completed 10-25-72 19
Application for plugging filed 1-27 1976
Application for plugging approved 1-29 1976
Plugging commenced 2-18 1976
Plugging completed 2-20 1976
Reason for abandonment of well or producing formation

If a producing well is abandoned, date of last production August 1974
Was permission obtained from the Conservation Division or its agents before plugging was commenced? Yes

Name of Conservation Agent who supervised plugging of this well Clarence Thomas
Producing formation Moopow Sand Depth to top Bottom Total Depth of Well 5975
Show depth and thickness of all water, oil and gas formations.

OIL, GAS OR WATER RECORDS

CASING RECORD

FORMATION	CONTENT	FROM	TO	SIZE	PUT IN	PULLED OUT
				8 5/8	1192	none
				4 1/2	5974	3225

Describe in detail the manner in which the well was plugged, indicating where the mud fluid was placed and the method or methods used in introducing it into the hole. If cement or other plugs were used, state the character of same and depth placed, from feet to feet for each plug set.

Pump 20 sks. of cement & 2 sks. of hulls from 5921 to 5700
Pump 50 sks. of cement to 1000 ft.
Put 15 sks. of cement from 401 to 400

RECEIVED
STATE CORPORATION COMMISSION

MAR 03 1976

CONSERVATION DIVISION
Wichita, Kansas

Name of Plugging Contractor Sargents Casing Pulling Service Kansas No. 511
Address Box 506 Liberal, Kansas 67901

STATE OF Oklahoma COUNTY OF Oklahoma ss.
Clare W. Headington (employee of owner) or (owner or operator) of the above-described well, being first duly sworn on oath, says: That I have knowledge of the facts, statements, and matters herein contained and the log of the above-described well as filed and that the same are true and correct. So help me God.

(Signature) Clare W. Headington
2820 Liberty Tower (Address)

SUBSCRIBED AND SWORN TO before me this 3rd day of March 1976

My commission expires 12-15-79 Laderna Moberly Notary Public.