


STATE OF KANSAS
STATE CORPORATION COMMISSION

WELL PLUGGING RECORD

Give All Information Completely
Make Required Affidavit
Mail or Deliver Report to
Conservation Division
State Corporation Comm.
245 North Water
Wichita, KS 67202

Meade County, Sec. 22 Twp. 34 Rge. 26 N/W
Location as "NE/CNW $\frac{1}{4}$ SW $\frac{1}{4}$ " or footage from lines
660' FSL and 1980' FEL
Lease Owner Getty Oil Company
Lease Name Dora Taylor Well No. 2
Office Address 2705 Vine St., Unit #4, Hays, KS 67601
Character of Well (Completed as Oil, Gas or Dry Hole)
Not completed, rig skidded due to crooked hole.
Date Well completed -- 19
Application for plugging filed -- 19
Application for plugging approved -- 19
Plugging commenced August 11 1983
Plugging completed August 11 1983
Reason for abandonment of well or producing formation
Crooked hole - rig skidded.
If a producing well is abandoned, date of last production -- 19

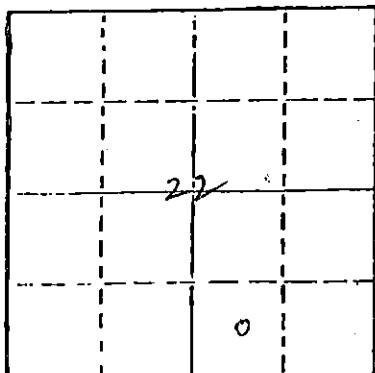

Locate well correctly on above
Section Plat

Name of Conservation Agent who supervised plugging of this well Steve Duran
Producing formation none Depth to top Bottom Total Depth of Well 1275'
Show depth and thickness of all water, oil and gas formations.

OIL, GAS OR WATER RECORDS

CASING RECORD

FORMATION	CONTENT	FROM	TO	SIZE	PUT IN	PULLED OUT
				16"	85'	None

Describe in detail the manner in which the well was plugged, indicating where the mud fluid was placed and the method or methods used in introducing it into the hold. If cement or other plugs were used, state the character of same and depth placed, from _____ feet to _____ feet for each plug set.

- 50 sx. 50-50 pozmix at 1275' to 1177'
- 50 sx. 50-50 pozmix at 720' to 622'
- 205 sx. 50-50 pozmix at 360' up to 3' below ground level.

(If additional description is necessary, use BACK of this sheet)


Name of Plugging Contractor Zenith Drilling Corporation

STATE OF Kansas COUNTY OF Ellis, ss.
Frank Renard (employee of owner) or (owner or operator)

of the above-described well, being first duly sworn on oath, says: That I have knowledge of the facts, statements, and matters herein contained and the log of the above-described well as filed and that the same are true and correct. So help me God.

(Signature) Frank Renard
2705 Vine St., Unit #4, Hays, KS 67601
(Address)

SUBSCRIBED AND SWORN TO before me this 15th day of August, 1983

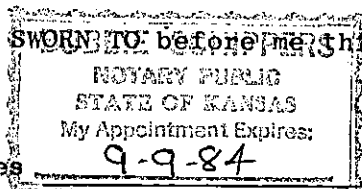

Robbie Schippers
Notary Public.

My commission expires 9-9-84

RECEIVED
STATE CORPORATION COMMISSION

AUG 16 1983

CONSERVATION DIVISION
Wichita, Kansas

INVOICED

DATE _____

INV. NO. _____