


STATE OF KANSAS
STATE CORPORATION COMMISSION

Give All Information Completely
Make Required Affidavit
Mail or Deliver Report to:
Conservation Division
State Corporation Commission
211 No. Broadway
Wichita, Kansas

WELL PLUGGING RECORD

NORTH

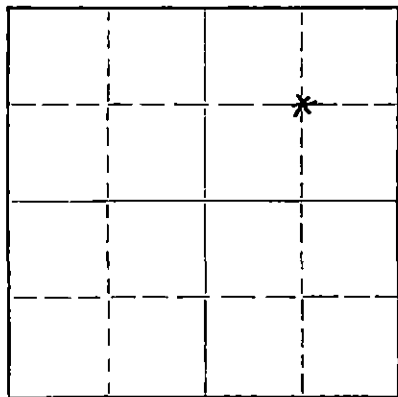

Locate well correctly on above
Section Plat

Meade County. Sec. 32 Twp. 34 Rge. 26 (E) (W)
Location as "NE/CNW/SW" or footage from lines C-NE
Lease Owner Anadarko Production Company
Lease Name Orem Well No. 1-32
Office Address Box 351, Liberal, Kansas
Character of Well (completed as Oil, Gas or Dry Hole) Dry Hole
Date well completed April 27 19 60
Application for plugging filed April 27 19 60
Application for plugging approved April 27 19 60
Plugging commenced April 27 19 60
Plugging completed April 28 19 60
Reason for abandonment of well or producing formation Dry

If a producing well is abandoned, date of last production _____ 19 ____
Was permission obtained from the Conservation Division or its agents before plugging was commenced? Yes

Name of Conservation Agent who supervised plugging of this well Bill Lachamp
Producing formation _____ Depth to top _____ Bottom _____ Total Depth of Well 624 Feet
Show depth and thickness of all water, oil and gas formations.

OIL, GAS OR WATER RECORDS

CASING RECORD

FORMATION	CONTENT	FROM	TO	SIZE	PUT IN	PULLED OUT
				8 5/8"	1500	None

Describe in detail the manner in which the well was plugged, indicating where the mud fluid was placed and the method or methods used in introducing it into the hole. If cement or other plugs were used, state the character of same and depth placed, from _____ feet to _____ feet for each plug set.

Filled hole with heavy mud to 600 feet, spotted 20 sack plug. Filled to 35 feet with heavy mud and spotted 10 sacks cement.

RECEIVED
STATE CORPORATION COMMISSION
MAY 4 1960
CONSERVATION DIVISION
Wichita, Kansas

(If additional description is necessary, use BACK of this sheet)

Name of Plugging Contractor _____
Address _____

STATE OF Kansas, COUNTY OF Seward, ss.
Anadarko Production Company (~~employee of owner~~) or (owner or operator) of the above-described well, being first duly sworn on oath, says: That I have knowledge of the facts, statements, and matters herein contained and the log of the above-described well as filed and that the same are true and correct. So help me God.

(Signature) R. L. Andrews Manager Drilling & Production
Box 351, Liberal, Kansas
(Address)

SUBSCRIBED AND SWORN TO before me this 29th day of April 1960
My Commission Expires December 8, 1963
Patricia J. Jackson Notary Public.



