


STATE OF KANSAS
STATE CORPORATION COMMISSION

15-175-20278-00-00

Give All Information Completely
Make Required Affidavit
Mail or Deliver Report to
Conservation Division
State Corporation Commission
245 North Water
Wichita, KS 67202

FORM CP-4

WELL PLUGGING RECORD

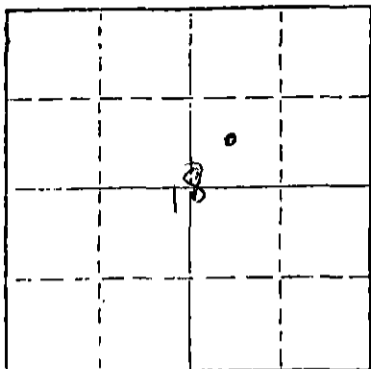

Locate well correctly on above Section Plat

Seward County, Sec. 18 Twp. 34S Rge. XXXXX 31 (W)
Location as "NE/CNW&SW" or footage from lines SW NE
Lease Owner Texaco Inc.
Lease Name Geraldynne Bloom Well No. 1
Office Address P.O. Box 2420, Tulsa, OK 74102
Character of Well (completed as Oil, Gas or Dry Hole) Dry hole
Date well completed 2/4/76 19
Application for plugging filed 2/9/76 19
Application for plugging approved 2/6/76 19
Plugging commenced 2/4/76 19
Plugging completed 2/4/76 19
Reason for abandonment of well or producing formation Non-producing
If a producing well is abandoned, date of last production NA 19
Was permission obtained from the Conservation Division or its agents before plugging was commenced? Yes

Name of Conservation Agent who supervised plugging of this well Clarence Thomas
Producing formation None Depth to top Bottom Total Depth of Well 4650 Feet
Show depth and thickness of all water, oil and gas formations.

OIL, GAS OR WATER RECORDS

CASING RECORD

FORMATION	CONTENT	FROM	TO	SIZE	PUT IN	PULLED OUT
				8-5/8"	1550'	none
	RECEIVED					
	STATE CORPORATION COMMISSION					
	FEB 23 1976		2-23-76			
	CONSERVATION DIVISION					
	Wichita, Kansas					

Describe in detail the manner in which the well was plugged, indicating where the mud fluid was placed and the method or methods used in introducing it into the hole. If cement or other plugs were used, state the character of same and depth placed, from feet to feet for each plug set.

PB 4650-1512' w/hvy mud, 1512-1320' w/50 sx poz,
1320-509' w/mud, 509-374' w/35 sx poz
374-45' w/mud, 45-4' w/15 sx cmt,
4'-surf w/soil.

PLUGGING COMPLETE

(If additional description is necessary, use BACK of this sheet)
Name of Plugging Contractor Gabbert & Jones, Inc.
Address 830 Sutton Place, Wichita, KS

STATE OF Oklahoma COUNTY OF Tulsa ss.
F. E. Anderson (employee of owner) or ~~XXXXXXXXXXXX~~ of the above-described well, being first duly sworn on oath, says: That I have knowledge of the facts, statements, and matters herein contained and the log of the above-described well as filed and that the same are true and correct. So help me God.

(Signature) F. E. Anderson Oper. Supt.
F. E. Anderson
P.O. Box 2420, Tulsa, OK 74102
(Address)

SUBSCRIBED AND SWORN TO before me this 17th day of February, 1976.

My commission expires Nov. 17, 1979

M. K. Vann
Notary Public.

M. K. VANN
MY COMMISSION EXPIRES
NOVEMBER 17, 1979

