


Give All Information Completely
Make Required Affidavit
Mail or Deliver Report to:
Conservation Division
State Corporation Commission
212 No. Market
Wichita, Kansas

WELL PLUGGING RECORD

NORTH

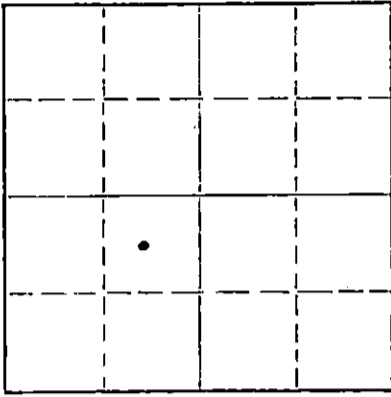

Locate well correctly on above
Section Plat

Seward County, Sec. 24 Twp. 34S Rge. (E) 31 (W)
Location as "NE/CNW&SW" or footage from lines 1980' FSL & 1980' FWL
Lease Owner Anadarko Production Company
Lease Name Keating "A" Well No. 1
Office Address Box 351, Liberal, Kansas 67901
Character of Well (completed as Oil, Gas or Dry Hole) Dry Hole
Date well completed November 3, 19 70
Application for plugging filed November 10, 19 70
Application for plugging approved November 9, 19 70
Plugging commenced November 3, 19 70
Plugging completed November 3, 19 70
Reason for abandonment of well or producing formation Dry Hole

If a producing well is abandoned, date of last production _____ 19 ____
Was permission obtained from the Conservation Division or its agents before plugging was commenced? YES

Name of Conservation Agent who supervised plugging of this well Mr. Ed Eves, Box "F", Sublette, Kansas
Producing formation _____ Depth to top _____ Bottom _____ Total Depth of Well 6105 Feet
Show depth and thickness of all water, oil and gas formations.

OIL, GAS OR WATER RECORDS

CASING RECORD

FORMATION	CONTENT	FROM	TO	SIZE	PUT IN	PULLED OUT
				8 5/8"	1324'	NONE

Describe in detail the manner in which the well was plugged, indicating where the mud fluid was placed and the method or methods used in introducing it into the hole. If cement or other plugs were used, state the character of same and depth placed, from _____ feet to _____ feet for each plug set.

Spotted 35 sxs. cement @ 1100' to 1000'.

Spotted 15 sxs. cement 35' to surface.

Hole filled with drilling mud.

RECEIVED
STATE CORPORATION COMMISSION
NOV 13 1970
CONSERVATION DIVISION
Wichita, Kansas

(If additional description is necessary, use BACK of this sheet)

Name of Plugging Contractor Zenith Drilling Corporation
Address Wichita, Kansas 67202

STATE OF KANSAS, COUNTY OF SEWARD, ss.
V. K. DOWNEY (employee of owner) or (owner or operator) of the above-described well, being first duly sworn on oath, says: That I have knowledge of the facts, statements, and matters herein contained and the log of the above-described well as filed and that the same are true and correct. So help me God.

(Signature) V. K. Downey


(Address)

SUBSCRIBED AND SWORN TO before me this 11 day of November, 19 70

My Commission Expires April 28, 1971

My commission expires _____

J. W. Williams
Notary Public.

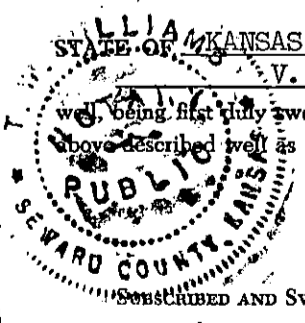

15-175-20130-00-00

DRILLER'S LOG

WELL NAME Keating "A" No. 1 COMPANY OPERATING Anadarko Production Company
 ADDRESS OF COMPANY Box 351. Liberal, Kansas 67901

WELL LOCATION C $\frac{1}{4}$ NE $\frac{1}{4}$ SW $\frac{1}{4}$
1980 Ft. North of South Line,
1980 Ft. East of West Line, Sec. 24, Twp. 34S, Rge. 31W, Seward County, Kansas

DRILLING STARTED 10-17, 19 70, DRILLING COMPLETED 11-3, 19 70
 WELL COMPLETED 11-3, 19 70, WELL CONNECTED _____, 19 _____

ELEVATION 2482.2 Ft. Ground Level CHARACTER of WELL (Oil, Gas, Dry Hole) Dry Hole

OIL OR GAS SANDS OR ZONES - PERFORATIONS - ACIDIZING AND FRACTURING INFORMATION					
Name	From	To	No. of Shots	Gallons Used	Kind Used

CASING RECORD

Size	Amount Set	Sacks of Cement	Amount Pulled
8 5/8"	1324'	700	NONE

FORMATION RECORD

Formation	Top	Bottom	Formation	Top	Bottom
Sand & Clay	0	100	Shale & Lime	5517	5750
Sand	100	300	Lime & Shale	5750	5989
Red Bed	300	1150	Lime	5989	6105
Red Bed & Anhydrite	1150	1325	Total Depth	6105	
Anhydrite & Red Bed	1325	1685			
Anhydrite & Shale	1685	2145			
Shale & Shells	2145	2329			
Shale & Lime	2329	2485			
Lime & Shale	2485	3597			
Shale & Lime	3597	4045			
Lime & Shale	4045	4250			
Lime	4250	5361			
Lime & Shale	5361	5517			

RECEIVED
 STATE CORPORATION COMMISSION
 NOV 13 1970
 CONSERVATION DIVISION
 Wichita, Kansas

RESULTS OF INITIAL PRODUCTION TEST: _____