


Give All Information Completely
Make Required Affidavit
Mail or Deliver Report to:
Conservation Division
State Corporation Commission
211 No. Broadway
Wichita, Kansas

WELL PLUGGING RECORD

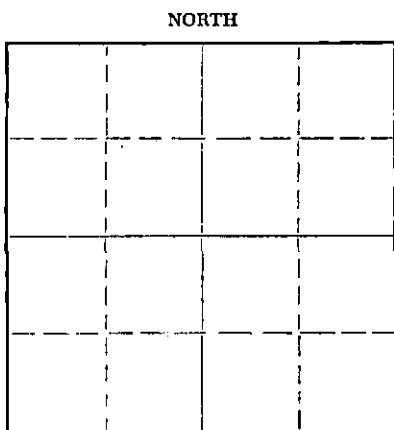

Locate well correctly on above
Section Plat

Seward County, Sec. 27 Twp. 34 Rge. 31 (E) (W)
Location as "NE/CNW4SW4" or footage from lines C SW NE
Lease Owner Anadarko Production Company
Lease Name York "A" Well No. 1
Office Address Box 351, Liberal, Kansas
Character of Well (completed as Oil, Gas or Dry Hole) Dry Hole
Date well completed August 29 19 64
Application for plugging filed August 31 19 64
Application for plugging approved 19
Plugging commenced August 29 19 64
Plugging completed August 29 19 64
Reason for abandonment of well or producing formation Dry

If a producing well is abandoned, date of last production 19
Was permission obtained from the Conservation Division or its agents before plugging was commenced? Yes

Name of Conservation Agent who supervised plugging of this well Hugh Scott
Producing formation Depth to top Bottom Total Depth of Well 6312 Feet
Show depth and thickness of all water, oil and gas formations.

OIL, GAS OR WATER RECORDS

CASING RECORD

FORMATION	CONTENT	FROM	TO	SIZE	PUT IN	PULLED OUT
				8 5/8	2405	None

Describe in detail the manner in which the well was plugged, indicating where the mud fluid was placed and the method or methods used in introducing it into the hole. If cement or other plugs were used, state the character of same and depth placed, from feet to feet for each plug set.
Spotted 35 sxs. cmt. @ 700' and 15 sxs. @ 45'.

RECEIVED
STATE CORPORATION COMMISSION

SEP 3 1964

CONSERVATION DIVISION
Wichita, Kansas

(If additional description is necessary, use BACK of this sheet)
Name of Plugging Contractor Moran Bros., Inc.
Address 1200 Oil & Gas Bldg. Wichita Falls, Texas

STATE OF Kansas, COUNTY OF Seward, ss.
S.H. Neither coat (employee of owner) or (owner or operator) of the above-described well, being first duly sworn on oath, says: That I have knowledge of the facts, statements, and matters herein contained and the log of the above-described well as filed and that the same are true and correct. So help me God.
(Signature) S.H. Neither coat

SUBSCRIBED AND SWORN to before me this 1st day of September, 19 64
Donald L. Vangieson (Address)
My commission expires _____
Donald L. Vangieson Notary Public.

MY COMMISSION EXPIRES SEPT. 29, 1964

15-175-~~10166~~-00-00

10156

DRILLER'S LOG

WELL NAME York "A" No. 1

COMPANY OPERATING Anadarko Production Company
 ADDRESS of COMPANY Box 351, Liberal, Kansas

WELL LOCATION C ½ SW ½ NE ½,
660 ft. North of South line,
660 ft. East of West line; Sec. 27 Twp. 34 Rge. 31, Seward County, Kansas

DRILLING STARTED 8/6, 1964 DRILLING COMPLETED 8/29, 1964
 WELL COMPLETED 8/29, 1964 WELL CONNECTED _____, 19____

ELEVATION 2537.9 ft. Ground Level CHARACTER OF WELL (Oil, Gas, or Dry Hole) Dry Hole

OIL OR GAS SANDS OR ZONES - PERFORATIONS - ACIDIZING AND FRACTURING INFORMATION					
Name	From	To	No. of Shots	Gallons Used	Kind Used

CASING RECORD

Size	Amount Set	Sacks of Cement	Amount Pulled
8 5/8	2405	600	None

FORMATION RECORD

Formation	Top	Bottom	Formation	Top	Bottom
Surface Sand	0	154	Lime & Sand	6018	6070
Surface Sand, Clay & Red Bed	154	1158	Lime	6070	6312
Anhydrite & Sand	1158	1440	Total Depth	6312	
Red Bed, Gypsum & Anhydrite	1440	1804			
Anhydrite & Shale	1804	2298			
Anhydrite	2298	2417			
Lime	2417	2508			
Shale & Lime	2508	4570			
Lime	4570	4770			
Shale & Lime	4770	5138			
Lime	5138	5540			
Shale & Lime	5540	6018			

RECEIVED
 STATE CORPORATION COMMISSION

SEP 3 1964

CONSERVATION DIVISION
 Wichita, Kansas

RESULTS of INITIAL PRODUCTION TEST: _____