

Give All Information Completely
Make Required Affidavit
Mail or Deliver Report to:
Conservation Division
State Corporation Commission
211 No. Broadway
Wichita, Kansas

WELL PLUGGING RECORD

Seward County, Sec. 22 Twp. 34S Rge. (E) 32 (W)

Location as "NE/CNW/SW" or footage from lines C E/2 SW/4

Lease Owner National Oil Company

Lease Name Blanche Well No. 1

Office Address Suite 550 - 200 W. Douglas

Character of Well (completed as Oil, Gas or Dry Hole) Dry Hole

Date well completed 2/25 1973

Application for plugging filed 2/25 1973

Application for plugging approved 2/25 1973


Plugging commenced 2/25 1973

Plugging completed 2/25 1973

Reason for abandonment of well or producing formation Dry Hole

If a producing well is abandoned, date of last production NA 19

Was permission obtained from the Conservation Division or its agents before plugging was commenced? Yes

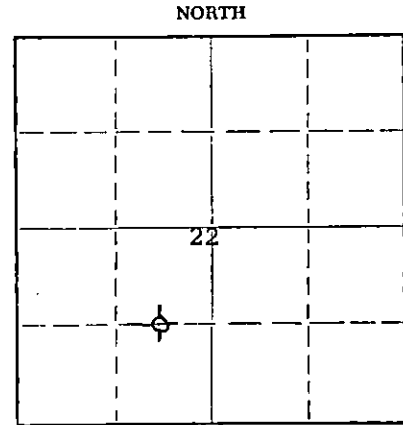

Locate well correctly on above Section Plat

Name of Conservation Agent who supervised plugging of this well Edgar J. Eves

Producing formation NA Depth to top Bottom Total Depth of Well 6140' KB Feet

Show depth and thickness of all water, oil and gas formations.

OIL, GAS OR WATER RECORDS

CASING RECORD

FORMATION	CONTENT	FROM	TO	SIZE	PUT IN	PULLED OUT
				20"	21	None
				8 5/8"	1510'	None

Describe in detail the manner in which the well was plugged, indicating where the mud fluid was placed and the method or methods used in introducing it into the hole. If cement or other plugs were used, state the character of same and depth placed, from feet to feet for each plug set.

Cement plug of 35 sx. Halliburton light weight set at 1100' to 1000' through open end drill pipe.

Cement plug of 15 sx. Halliburton light weight set at 45' to 5' through open end drill pipe. Plug rat hole w/5 sx. and mouse hole w/5 sx.

RECEIVED
STATE CORPORATION COMMISSION

MAR 8 1973

CONSERVATION DIVISION
Wichita, Kansas

(If additional description is necessary, use BACK of this sheet)

Name of Plugging Contractor Rine Drilling Company

Address Suite 600 - 300 West Douglas, Wichita, Kansas 67202

STATE OF KANSAS, COUNTY OF SEDGWICK, ss.

R. M. Green (employee of owner) or (owner or operator) of the above-described well, being first duly sworn on oath, says: That I have knowledge of the facts, statements, and matters herein contained and the log of the above-described well as filed and that the same are true and correct. So help me God.

(Signature) R. M. Green R. M. Green

Suite 600-300 West Douglas, Wichita, Kansas (Address)

SWORN TO before me this 7th day of March, 1973

Carol J. Hladik Notary Public.



C E/2
SECTION 22-34S-32W
SEWARD COUNTY, KANSAS

BLANCHE #1

CONTRACTOR: RINE DRILLING COMPANY

STARTED: FEBRUARY 13, 1973

COMPLETED: FEBRUARY 26, 1973

L O G

Clay & Sand	40'	-	1130'
Sand & Red Bed	1130'	-	1510'
Sand & Anhydrite	1510'	-	1625'
Anhydrite & Shale	1625'	-	2715'
Lime & Shale	2715'	-	5280'
Lime	5280'	-	5390'
Lime & Shale	5390'	-	6010'
Lime	6010'	-	6083'
Lime & Shale	6083'	-	6140'
Lime	6140'	-	6140'

Totco 1/4° @ 260'; 1/4° @ 780'
 Totco - 1° @ 1510'. Run 48 jts. of
 8 5/8" csg. set @ 1510'. Cement
 w/550 sx. lt. wt. +2% cc. Follow
 w/150 sx. common +3% cc

Totco - 1° @ 2150'; 1° @ 2558'
 Totco - 1° @ 3912'; 1 1/4° @ 4451'

Totco - 3/4° @ 5957'

TD - Spot 35 sx., plug @ 1100'
 Spot 15 sx., plug @ 45'
 Spot 10 sx., plug RH & MH

STATE OF KANSAS)
COUNTY OF SEDGWICK) ss

I, R. M. Green, do hereby certify that the above is a true and accurate log of the Blanche #1 located C of E/2 of Section 22-34S-32W, Seward County, Kansas.

R. M. Green
R. M. Green, Secretary-Treasurer

Subscribed and sworn to before me this 7th day of March, 1973.

J. W. Walker
T. W. Walker, Notary Public



RECEIVED
STATE CORPORATION COMMISSION
MAR 8 1973
CONSERVATION DIVISION
Wichita, Kansas