

15-119-20186-0000

RECEIVED


MAR 7 1975

STATE OF KANSAS
STATE CORPORATION COMMISSION

AMA. PROD.

WELL PLUGGING RECORD

File All Information Completely
Make Required Affidavit
Must be Delivered Promptly to
Conservation Division
State Corporation Commission
P. O. Box 17027
Wichita, Kansas 67217

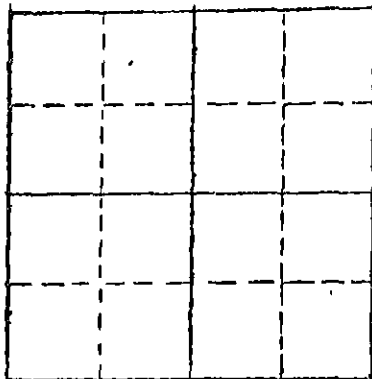

Locate well correctly on above
Section Plot

Location at "NE/CNWSW" or footage from lines Meade County, Sec. 8 Twp. 35S Rgc. 28W (E) (W)
C. NW/4
Lease Owner Mesa Petroleum Company
Lease Name Merkle 1-8 Well No. 1-8
Office Address P. O. Box 2009, Amarillo, Texas 79105
Character of Well (completed as Oil, Gas or Dry Hole) Dry Hole
Date well completed February 28, 1975 19
Application for plugging filed February 28, 1975 19
Application for plugging approved February 28, 1975 19
Plugging commenced 9:00 PM, February 28, 1975 19
Plugging completed 11:00 PM, February 28, 1975 19
Reason for abandonment of well or producing formation Dry Hole

If a producing well is abandoned, date of last production _____ 19____
Was permission obtained from the Conservation Division or its agents before plugging was commenced? Yes

Name of Conservation Agent who supervised plugging of this well Edgar J. Eves
Producing formation _____ Depth to top _____ Bottom _____ Total Depth of Well 6150' Feet
Show depth and thickness of all water, oil and gas formations.

OIL, GAS OR WATER RECORDS

CASING RECORD

FORMATION	CONTENT	FROM	TO	SIZE	PUT IN	PULLED OUT
				8 5/8"	1145'	None

Describe in detail the manner in which the well was plugged, indicating where the mud fluid was placed and the method or methods used in introducing it into the hole. If cement or other plugs were used, state the character of same and depth placed, from _____ feet to _____ feet for each plug set.

Filled hole with heavy mud.
Plugged hole with Halliburton plug -
60 sacks cement at bottom of surface
1540' to 1340'; 35 sacks at 700';
plug and 15 sacks at 10' to base of
cellar.

RECEIVED
STATE CORPORATION COMMISSION
MAY 2 1975
CONSERVATION DIVISION
Wichita, Kansas

Name of Plugging Contractor Sterling Drilling Company (If additional description is necessary, use BACK of this sheet)
Address P. O. Box 129, Sterling, Kansas 67579

STATE OF KANSAS COUNTY OF RICE ss.
Bernard Laudermilk, (employ of owner) or (owner or operator) of the above-described

well, being first duly sworn on oath, says: That I have knowledge of the facts, statements, and matters herein contained and the log of the above described well as filed and that the same are true and correct. So help me God. STERLING DRILLING COMPANY
(Signature) Bernard Laudermilk
Bernard Laudermilk, Vice President
P. O. Box 129, Sterling, Kansas 67579 (Address)

SWORN to before me this 5th day of March 1975
Charles M. Hall
Charles M. Hall, Notary Public.
My Commission Expires Jan. 6, 1978



15-119-20186-0000

STERLING DRILLING COMPANY
P. O. Box 129
Sterling, Kansas 67579

WELL LOG ----- MERKLE 1-8

Located: C NW/4, Section 8-35S-28W, Meade County, Kansas

OWNER: Mesa Petroleum Company
ROTARY DRILLING CONTRACTOR: Sterling Drilling Company

COMMENCED: February 4, 1975
COMPLETED: February 26, 1975

TOTAL DEPTH: 6150'

LOG	CASING RECORD
0 - 410 Clay and Sand	Ran 36 joints 28# used casing, 1357' set at 1145' K.B. with 450 sacks 35/65 Pozmix, 6% gel, 2% cc, 1/4# D-29 per sack, followed with 150 sacks Class H, 3% cc. Plug down at 10:00 PM, 2-5-75.
410 - 1215 Clay, Sand and Shale	
1215 - 1445 Clay	
1445 - 2185 Shale	
2185 - 4880 Lime and Shale	
4880 - 4975 Lime	
4975 - 5430 Lime and Shale	
5430 - 5470 Lime	
5470 - 5605 Lime and Shale	
5605 - 5640 Lime	
5640 - 6150 Lime and Shale	Plugged.

RECEIVED
STATE CORPORATION COMMISSION
MAY 2 1975
CONSERVATION DIVISION
Wichita, Kansas