

STATE OF KANSAS
STATE CORPORATION COMMISSION

WELL PLUGGING RECORD

Give All Information Completely
Make Required Affidavit
Mail or Deliver Report to:
Conservation Division
State Corporation Commission
211 No. Broadway
Wichita, Kansas

Meade County. Sec. 7 Twp. 35S Rge. 28W (E) (W) NW

Location as "NE/CNW/SW" or footage from lines 660' F/S&W lines NW/4 NW/4

Lease Owner Sinclair Oil & Gas Company

Lease Name A. J. Merkle Well No. 1

Office Address P. O. Box 521, Tulsa, Oklahoma

Character of Well (completed as Oil, Gas or Dry Hole) Dry Hole

Date well completed 9-10-58 19

Application for plugging filed 9-10-58 19

Application for plugging approved 9-10-58 19


Plugging commenced 9-10-58 19

Plugging completed 9-10-58 19

Reason for abandonment of well or producing formation
No producing formations encountered

If a producing well is abandoned, date of last production _____ 19

Was permission obtained from the Conservation Division or its agents before plugging was commenced? Yes

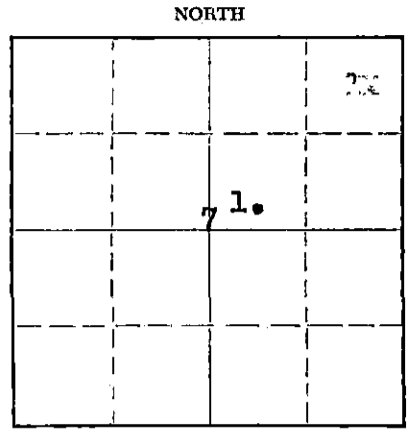

Locate well correctly on above Section Plat

Name of Conservation Agent who supervised plugging of this well Mr. M. A. Rives

Producing formation None Depth to top _____ Bottom _____ Total Depth of Well 6215 Feet

Show depth and thickness of all water, oil and gas formations.

OIL, GAS OR WATER RECORDS

CASING RECORD

FORMATION	CONTENT	FROM	TO	SIZE	PUT IN	PULLED OUT
<u>No oil formations encountered</u>						

Describe in detail the manner in which the well was plugged, indicating where the mud fluid was placed and the method or methods used in introducing it into the hole. If cement or other plugs were used, state the character of same and depth placed, from _____ feet to _____ feet for each plug set.

6215 From 6215 to 400' with 10# drilling mud, from 400' to 375' with 30 sacks cement, from 375' to 20' with drilling mud and from 20' to surface with 30 sacks cement. Completed plugging and abandoning at 11:30 AM 9-10-58

(If additional description is necessary, use BACK of this sheet)

Name of Plugging Contractor D & M Drilling Company

Address P. O. Box 247, Great Bend, Kansas

STATE OF Kansas, COUNTY OF Rice, ss. W. B. Rhees (employee of owner) or (owner or operator) of the above-described

well, being first duly sworn on oath, says: That I have knowledge of the facts, statements, and matters herein contained and the log of the above-described well as filed and that the same are true and correct. So help me God.

(Signature) W B Rhees
Box 551, Chase, Kansas (Address)

SUBSCRIBED AND SWORN to before me this 27th day of September, 1958

STATE CORPORATION COMMISSION L B Reynolds Notary Public.

My commission expires August 13, 1962

OCT 1 1958
10-1-58

PLUGGING
FILE SEC 7 T 35 R 28W
BOOK PAGE 130 LINE 22

MERKLE #1

NW/4 Section 7-35S-28W, Meade County, Kansas

Rigged up Rotary Tools 8/7/58

Ran 23 Jts. (615.36') 13 3/8" surface pipe set @ 588'. Cemented w/500 sacks cement, 2% CC

Tore down Rotary Tools 9/10/58

FORMATION	FROM	TO
Sand & Clay	0'	200'
Sand, shale & shells	200	375
Redbed	375	430
Redbed & sand	430	825
Redbed & shells	825	1180
Redbed w/Anhydrite streaks	1180	1565
Shale & shells	1565	1633
Red shale & anhydrite	1633	1680
Redbed, shale & shells	1680	1772
Shale & shells	1772	1850
Shale w/anhydrite streaks	1850	1970
Shale & shells	1970	2135
Lime & shale	2135	2215
Lime	2215	2445
Lime & anhydrite	2445	2496
Lime & shale	2496	2626
Lime	2626	2716
Lime & shale	2716	2976
Lime, shale & chert	2976	3051
Lime w/chert streaks	3051	3146
Lime & shale	3146	3320
Lime	3320	3390
Lime & shale	3390	3464
Lime	3464	3535
Lime & chalk	3535	3590
Lime	3590	3760
Shale	3760	3855
Lime & shale	3855	3961
Shale	3961	4085
Shale & sand	4085	4255
Shale	4255	4455
Shale & lime	4455	4595
Lime	4595	4650
Lime & shale	4650	4816
Lime	4816	4873
Lime & chalk	4873	4932
Lime	4932	5280
Lime & shale	5280	5328
Lime	5328	5650
Lime & shale	5650	5943
Sand	5943	5960
Lime & shale	5960	6067
Lime	6067	6080
Lime w/shale streaks	6080	6155
Lime	6155	6215

RECEIVED
STATE CORPORATION COMMISSION
SEP 19 1958
DIVISION

PLUGGING
FILE SEC 7 T 35 R 28W
BOOK PAGE 130 LINE 22

T. D.

I, Don S. Packer, do hereby certify that the foregoing log is true and correct, to the best of my knowledge and belief.

Don S. Packer
Don S. Packer

Subscribed and sworn to before me this 16th day of September, 1958

My Comm. Expires: 9/29/61

June Swamy (Notary Public)