


STATE OF KANSAS  
STATE CORPORATION COMMISSION

WELL PLUGGING RECORD

Give All Information Completely  
Make Required Affidavit  
Mail or Deliver Report to:  
Conservation Division  
State Corporation Commission  
800 Biting Building  
Wichita, Kansas

Meade County. Sec. 2 Twp. 35S Rge. (E) 28 (W)  
Location as "NE/CNW/SW" or footage from lines SW/4 SW/4 NE/4  
Lease Owner Skelly Oil Company  
Lease Name E. R. Hanson Well No. 1  
Office Address Box 1650, Tulsa, Oklahoma  
Character of Well (completed as Oil, Gas or Dry Hole) Dry Hole  
Date well completed September 4, 19 53  
Application for plugging filed September 5, 19 53  
Application for plugging approved September 8, 19 53  
Plugging commenced September 5, 19 53  
Plugging completed September 5, 19 53  
Reason for abandonment of well or producing formation Dry Hole

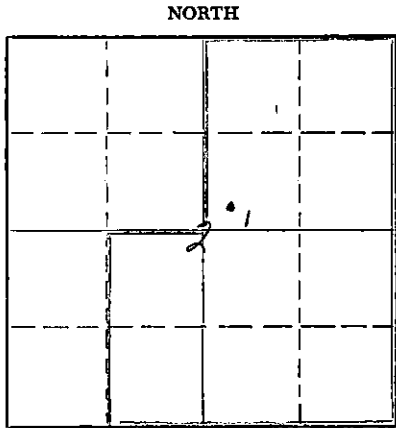

Locate well correctly on above  
Section Plat

If a producing well is abandoned, date of last production \_\_\_\_\_ 19\_\_\_\_  
Was permission obtained from the Conservation Division or its agents before plugging was commenced? Yes (verbally)

Name of Conservation Agent who supervised plugging of this well Mr. M. A. Rives  
Producing formation \_\_\_\_\_ Depth to top \_\_\_\_\_ Bottom \_\_\_\_\_ Total Depth of Well 6617 Feet  
Show depth and thickness of all water, oil and gas formations.

OIL, GAS OR WATER RECORDS

CASING RECORD

FORMATION	CONTENT	FROM	TO	OD SIZE	PUT IN	PULLED OUT
Mississippi Lime	Dry	6085'	6513'	9-5/8"	1305' 0"	None

Describe in detail the manner in which the well was plugged, indicating where the mud fluid was placed and the method or methods used in introducing it into the hole. If cement or other plugs were used, state the character of same and depth placed, from \_\_\_\_\_ feet to \_\_\_\_\_ feet for each plug set.

50 sacks of cement	6617' to 6480'
Mud laden fluid	6480' to 500'
40 sacks of cement	500' to 420'
Mud laden fluid	420' to 20'
10 sacks of cement	20' to 6'
Surface soil	6' to 0'

(If additional description is necessary, use BACK of this sheet)

Name of Plugging Contractor. Nichols-Duncan Drilling Company  
Address Duncan, Oklahoma

STATE OF Kansas, COUNTY OF Reno, ss.  
H. E. Wamsley (employee of owner) of the above-described well, being first duly sworn on oath, says: That I have knowledge of the facts, statements and matters herein contained and the log of the above-described well as filed and that the same are true and correct. So help me God.

(Signature) [Signature]

Box 391, Hutchinson, Kansas

(Address)

SUBSCRIBED AND SWORN TO before me this 22nd day of September, 19 53

My commission expires April 7, 1955


[Signature] Notary Public.

PLUGGING  
FILE SEC 2 T 35 R 28  
BOOK PAGE 127 LINE 14

9-23-53

15-119-00148-0000

# SKELLY OIL COMPANY

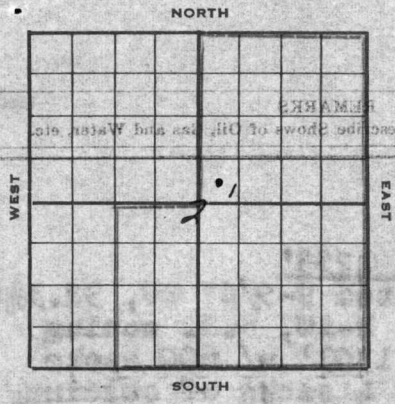

Well Record  
 44570  
 Lease Name and No. **E. R. Hanson** Well No. **1** Elev. **2379' RB**  
 Lease Description **1/2 & 1/2 SW/4 Sec. 2-35-28N,**  
**Neade County, Kansas (400 Acres)**

Location made **July 9, 1953** by **Neade County Engineer**  
**NE/4**  
 feet from North line **330** feet from East line **330**  
 feet from South line **330** feet from West line of **Sec. 2**  
 Work com'd **7/12 1953** Rig com'd **7/17 1953** Drlg. com'd **7/17 1953** Drlg. comp'd **9/3 1953**

Rig Contractor **Nichols-Duncan Drilling Company**  
 Drilling Contractor **Nichols-Duncan Drilling Company, Duncan, Oklahoma**  
 Rotary Drilling from **0'** to **6617'** Cable Tool Drilling from \_\_\_\_\_ to \_\_\_\_\_

Commenced Producing **DRY HOLE** 19 \_\_\_\_\_  
 Initial Prod. before shot or acid \_\_\_\_\_ Bbls.  
 Initial Prod. after shot or acid \_\_\_\_\_ Bbls.  
 Dry Gas Well Press \_\_\_\_\_ Volume \_\_\_\_\_ Cu. ft.  
 Casing Head Gas Pressure \_\_\_\_\_ Volume \_\_\_\_\_ Cu. ft.  
 Braden Head ( \_\_\_\_\_ Size ) Gas Pressure \_\_\_\_\_ Volume \_\_\_\_\_ Cu. ft.  
 Braden Head ( \_\_\_\_\_ Size ) Gas Pressure \_\_\_\_\_ Volume \_\_\_\_\_ Cu. ft.

PRODUCING FORMATION **DRY HOLE** Top \_\_\_\_\_ Bottom \_\_\_\_\_ TOTAL DEPTH **6617'**  
 (Name)

### CASING RECORD

OD Size	Wt.	Thds.	Where Set	PULLED OUT			LEFT IN			KIND	Cond'n	Sacks Used	CEMENTING Method Employed
				Jts.	Feet	In.	Jts.	Feet	In.				
9-5/8"	32.38	1303'					60	1305'	0	H40 R2 SS A	600	Halliburton	
(9-5/8" casing set 2' in cellar)													

Liner Set at \_\_\_\_\_ Length \_\_\_\_\_ Perforated at \_\_\_\_\_  
 Liner Set at \_\_\_\_\_ Length \_\_\_\_\_ Perforated at \_\_\_\_\_  
 Packer Set at \_\_\_\_\_ Size and Kind \_\_\_\_\_  
 Packer Set at \_\_\_\_\_ Size and Kind \_\_\_\_\_

### SHOT OR ACID TREATMENT RECORD

	FIRST		SECOND		THIRD		FOURTH	
Date								
Acid Used								
Size Shot								
Shot Between	Ft. and	Ft.	Ft. and	Ft.	Ft. and	Ft.	Ft. and	Ft.
Size of Shell								
Put in by (Co.)								
Length anchor								
Distance below Cas'g								
Damage to Casing or Casing Shoulder								

### SIGNIFICANT GEOLOGICAL FORMATIONS

NAME	Top	Bottom	GAS		OIL		REMARKS
			From	To	From	To	
Heebner shale	4465'						
Toronto Lime	4491'						
Lansing Lime	4609'						
Marnaton Lime	5333'						
Morrow Sand	6000'						
Chester	6085'						

### CLEANING OUT RECORDS

	DATE COMMENCED	DATE COMPLETED	PROD. BEFORE	PROD. AFTER	REMARKS
1st					See Reverse for other details.
2nd					" " " " "
3rd					" " " " "
4th					" " " " "

### PLUGGING BACK AND DEEPENING RECORDS

	Date Commenced	Date Completed	No. Feet Plugged Back or Deepened	Prod. Before	Prod. After	REMARKS
1st						See Reverse for other details.
2nd						" " " " "
3rd						" " " " "
4th						" " " " "

**PLUGGING**  
 FILE SEC **2 T 35 R 380** Reverse for Record of Formation)  
 BOOK PAGE **127** LINE **14**

FORMATION	TOP	BOTTOM	REMARKS
Surface soil and sand	0	74	
Surface sand and gravel	74	525	
Red bed and shells	525	1120	
Shale and shells	1120	1303	TOP ANHYDRITE 1255'
			Set and cemented 9-5/8" OD, 32.3# BR thd., R-2, H-40, S.S. casing (A cond.) at 1303' w/ 600 sacks of cement and 4 sacks of calcium chloride. Cement circulated.
Salt, shale and shells	1303	2025	TOP WELLINGTON 1934'
Shale and anhydrite	2025	2574	
Anhydrite, lime and shale	2574	2773	TOP HERRINGTON 2600'
			TOP RAIDER 2650'
			TOP WINFIELD 2703'
			TOP LYLE 2748'
Shale and lime	2773	3881	TOP TORAMBA 2782'
			TOP AILEY 2838'
			TOP ASSUNABAW 3599'
Shale	3881	3938	
Lime and shale	3938	4111	
Shale	4111	4201	
Shale and shells	4201	4380	
Shale	4380	4443	
Shale and lime	4443	4520	TOP HERRING SHALE 4465'

FORMATION	TOP	BOTTOM	REMARKS
Lime and shale	4520	4547	TOP LANSING LINE 4609'
Lime	4547	4597	San Halliburton drill stem test, packer set at 4465', used 55' anchor, open 45 minutes, light flow for 45 minutes, recovered 500' of muddy water, BHP-2000#.
Lime and shale	4597	4640	
Lime	4640	4713	TOP LANSING LINE 4609'
			San Halliburton drill stem test, packer set at 4634', used 79' of anchor, open 45 minutes, good blow to weak blow for 45 minutes, recovered 2600' of salt water, BHP-1625#.
Lime	4713	4810	San Halliburton drill stem test, packer set at 4713', used 97' anchor, open 45 minutes, good blow for 45 minutes, recovered 4000' of salt water, BHP-1700#.
Lime	4810	4903	
Lime and chert	4903	4929	SHOT OR ACID MEMORANDUM
Lime	4929	5028	San Halliburton drill stem test, packer set at 4895', used 43' anchor, open 45 minutes, light blow for 45 minutes, recovered 450' of mud and salt water, BHP-1800#.
Lime	5028	5084	
Lime and shale	5084	5113	
Lime	5113	5145	
Lime and shale	5145	5288	
Lime	5288	5316	
Lime and shale	5316	5400	TOP HERRINGTON LINE 5335'

FORMATION	TOP	BOTTOM	REMARKS
Shale and lime	5400	5483	
Lime	5483	5485	San Johnston drill stem test, packer set at 5399', used 68' anchor, open 45 minutes, light blow for 1 minute, recovered 30' drilling mud, BHP-550#.
Lime	5485	5500	
Lime and shale	5500	5538	
Lime	5538	5574	TOP CHEROKEE LINE 5572'
Lime and chert	5574	5603	
Lime and shale	5603	5950	TOP HERRINGTON SHALE 5926'
			TOP HERRINGTON LINE 5948'

Cored from 5950' to 5996' - Recovered 37'

- Top 8' - Gray, finely crystalline lime with vertical fractures
- Next 4' - Black shale
- Next 5' - Gray, finely crystalline, fragmented lime with few vertical fractures.
- Next 2' - Fine to medium crystalline, slightly shaley lime
- Next 1' - Dark gray shale
- Next 5' - Gray to tan mottled dense lime with vertical fractures

RECEIVED  
 1950  
 RECORD OF FORMATIONS

- Next 1' - Gray shale
- Next 6' - Tan, finely crystalline dense lime with vertical fractures
- Next 2' - Gray finely crystalline fossiliferous lime
- Last 3' - Gray argillaceous dense broken lime with some gray shale

Cored from 5996' to 6039' - Recovered 25'

- Top 3' - Light green mottled finely crystalline nodular lime
- Next 1' - Gray glauconitic conglomeratic fossiliferous shaley lime
- Next 7' - Gray tight fine grained quartzitic very slightly porous sand
- Next 6' - Dark gray flakey shale with thin streaks of silt stone
- Next 3' - Gray shaley quartzitic silt stone
- Next 4' - Light gray fine grained quartzitic shaley very slightly porous sand
- Last 1' - Dark gray blocky shale

Ran Halliburton drill stem test, packer set at 5956', used 83' anchor, open 1 hour, light blow for 15 minutes, recovered 15' of drilling mud, BHP-100%.

Cored from 6039' to 6048' - No recovery

Core barrel quit cutting - Sample showed black rotten shale which would not hold in core catcher

Lime and shale 6048 6055

Cored from 6055' to 6099 1/2' - Recovered 44 1/2'

- Top 20' - Fine grained, slightly glauconitic sand with thin shale laminations, slight to fair porosity, quartzitic in part.
- Next 2' - Fine to medium grained slightly glauconitic quartzitic very shaley sand
- Next 5' - Gray shale interbedded with fine to medium grained shaley sand
- Next 1' - Tan, hard dense sublithographic lime
- Next 6' - Gray, fine crystalline argillaceous dense fossiliferous lime with vertical fractures
- Next 2' - Lime as above interbedded with dark gray waxy shale
- Last 8' 6" - Gray to tan dense finely crystalline fossiliferous lime with vertical fractures and few streaks of gray shale

Ran Johnston drill stem test, packer set at 6023', used 76 1/2' anchor, packer did not hold - Pulled and reran packer and set packer at 5980 1/2', used 119' of anchor, open 45 minutes, light blow for 10 minutes, recovered 10' of drilling mud, BHP-54.5%.

Cored from 6099 1/2' to 6155' - Recovered 55 1/2'

- Top 4' 6" - Gray, fine to medium crystalline dense lime
- Next 3' - Gray, finely crystalline, slightly shaley lime with vertical fractures
- Next 22' - Tan, medium to coarse crystalline fossiliferous lime with very slight scattered intercrystalline porosity
- Next 2' - Gray, finely crystalline fossiliferous very shaley lime
- Next 9' - Tan, very fine crystalline dense styalitic lime with shale partings
- Next 11' - Light gray, fine to medium crystalline slightly fossiliferous fragmented lime with few streaks of gray shale and some vertical fractures
- Last 4' - Gray, finely crystalline highly fragmented fossiliferous lime interbedded with black fossiliferous shale.

Ran Halliburton drill stem test, packer set at 6095', used 60' anchor, open 1 hour, very light blow for 45 minutes, recovered 30' of drilling mud, BHP-100%.

Lime and shale 6155 6170  
Lime 6170 6195  
Lime and shale 6195 6232

Ran Halliburton drill stem test, packer set at 6155', used 77' of anchor, open 45 minutes, very light blow for 5 minutes, recovered 15' of drilling mud, BHP-0%.  
Ran Halliburton drill stem test, packer set at 6238', used 54' anchor, open 1 hour, light blow for 10 minutes, recovered 20' of drilling mud, BHP-0%.

Shale and lime 6232 6292



Lime and shale	6292	6344
Sand, lime and shale	6344	6387
Lime and shale	6387	6433
Sand, lime and shale	6433	6458
Sand and lime	6458	6469
Lime	6469	6490
Sandy lime	6490	6511

Ran Halliburton drill stem test, packer set at 6285', open 1 hour, light blow for 15 mins., recovered 90' drilling mud, BHP-1040'.

Lime and shale	6511	6546
Sand and lime	6546	6559
Lime, sand and shale	6559	6576
Sandy lime	6576	6597
Lime and shale	6597	6617

**TOP ST. GENEVIEVE 6513'**  
Ran Halliburton drill stem test, packer set at 6455', open 45 minutes, light blow for 5 mins., recovered 20' drilling mud, BHP-0'.

Ran Halliburton drill stem test, packer set at 6497', packer did not hold. Pulled and reran tester with 93' of anchor and set packer at 6524', open 1 hr., good blow for 30 mins., diminishing to light blow for 30 mins., recovered 900' of muddy salt water, BHP-2350'. Pulled drill pipe. Ran back and conditioned hole. Ran Schlumberger Survey.

**TOTAL DEPTH 6617'**

Since no commercial pay zones were encountered in drilling to 6617', regular authority was granted on September 5, 1953, to plug and abandon the well. On this date the well was plugged as follows:

50 sacks of cement	6617'	to	6480'
Mud laden fluid	6480'	to	500'
40 sacks of cement	500'	to	420'
Mud laden fluid	420'	to	20'
10 sacks of cement	20'	to	6'
Surface soil	6'	to	0'

Plugged and abandoned September 5, 1953.

**SLOPE TEST DATA**

DEPTH	ANGLE OF DEFLECTION
500'	1 Degree
1000'	1/2 "
2000'	0 "
2500'	1 "
3000'	1 1/2 "
3500'	1-3/4 "
4500'	1 "
5000'	1 "
5485'	1-3/4 "


**WATER ANALYSIS**

Pawhuska Research Laboratory  
Dept #: 4634' to 4713'

	PPM
Chlorides as Cl.	138,507
Sulfates as SO <sub>4</sub>	618
Chlorides as NaCl.	228,306
Sulfates as CaSO <sub>4</sub>	876
Chlorides as CaCl <sub>2</sub>	216,791
Sulfates as H <sub>2</sub> SO <sub>4</sub>	631

Depth: 4713' to 4810'

Chlorides as Cl.	139,003
Sulfates as SO <sub>4</sub>	628
Chlorides as NaCl.	229,182
Sulfates as CaSO <sub>4</sub>	889
Chlorides as CaCl <sub>2</sub>	217,567
Sulfates as H <sub>2</sub> SO <sub>4</sub>	641

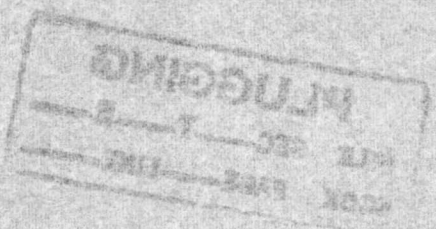

WATER ANALYSIS

Depth: 4465' to 4520'

August 24, 1953

	PPM
Chlorides as Cl. . . . .	26,772
Sulfates as SO <sub>4</sub> . . . . .	2,152
Chlorides as NaCl. . . . .	44,130
Sulfates as CaSO <sub>4</sub> . . . . .	3,050
Chlorides as CaCl <sub>2</sub> . . . . .	41,903
Sulfates as H <sub>2</sub> SO <sub>4</sub> . . . . .	2,197

---

Depth: 4985' to 5028'

August 24, 1953

Chlorides as Cl. . . . .	58,154
Sulfates as SO <sub>4</sub> . . . . .	1,405
Chlorides as NaCl. . . . .	95,850
Sulfates as CaSO <sub>4</sub> . . . . .	1,992
Chlorides as CaCl <sub>2</sub> . . . . .	92,352
Sulfates as H <sub>2</sub> SO <sub>4</sub> . . . . .	1,435

---

Depth: 5317' to 5400'

August 24, 1953

Chlorides as Cl. . . . .	76,345
Sulfates as SO <sub>4</sub> . . . . .	1,356
Chlorides as NaCl. . . . .	125,843
Sulfates as CaSO <sub>4</sub> . . . . .	1,921
Chlorides as CaCl <sub>2</sub> . . . . .	119,491
Sulfates as H <sub>2</sub> SO <sub>4</sub> . . . . .	1,384

---

Depth: 6524' to 6617'

September 14, 1953

Chlorides as Cl. . . . .	17,198
Chlorides as NaCl. . . . .	28,348
Chlorides as CaCl. . . . .	26,918
Sulfates as SO <sub>4</sub> . . . . .	1,903
Sulfates as CaSO <sub>4</sub> . . . . .	2,696
Sulfates as H <sub>2</sub> SO <sub>4</sub> . . . . .	1,942

Esbeck  
 Fidelity Onion Skin  
 MADE IN U.S.A.

**PLUGGING**  
 FILE SEC—T—R—  
 BOOK PAGE—LINE—