

STATE OF KANSAS
STATE CORPORATION COMMISSION
CONSERVATION DIVISION
P. O. BOX 17027
WICHITA, KANSAS 67217

FORM CP-4

WELL PLUGGING RECORD

Meade County, Sec. 18 Twp. 35 Rge. - (E) 30 (W)

Location as "NE/CNWSW" or footage from lines 410' FWL & 1980' FNL

Lease Owner InterNorth Inc.

Lease Name Adams 18 Well No. #1

Office Address Box 35288, Tulsa, Oklahoma 74135

Character of Well (completed as Oil, Gas or Dry Hole) Dry Hole

Date well completed 6-9 19 81

Application for plugging filed 6-10 19 81

Application for plugging approved 6-10 19 81


Plugging commenced 6-10 19 81

Plugging completed 6-10 19 81

Reason for abandonment of well or producing formation Dry Hole

If a producing well is abandoned, date of last production 19

Was permission obtained from the Conservation Division or its agents before plugging was commenced? yes

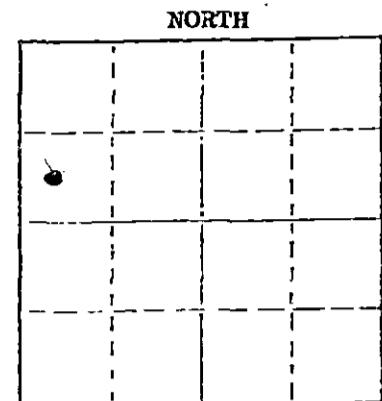

Locate well correctly on above Section Plat

Name of Conservation Agent who supervised plugging of this well Clarence Thomas

Producing formation X Depth to top X Bottom X Total Depth of Well 6750

Show depth and thickness of all water, oil and gas formations.

OIL, GAS OR WATER RECORDS				CASING RECORD		
FORMATION	CONTENT	FROM	TO	SIZE	PUT IN	PULLED OUT
				20"	60"	NONE
				8 5/8	1492'	NONE

Describe in detail the manner in which the well was plugged, indicating where the mud fluid was placed and the method or methods used in introducing it into the hole. If cement or other plugs were used, state the character of same and depth placed, from feet to feet for each plug set.

- 67 Vis. mud from Id. to Surface
- 50 sx.-(1700'-1800')
- 50 sx.-(1375'-1475')
- 25 sx.-(700'- 750')
- 10 sx.-(40'- 0')
- 5 sx.-Rathole
- 5 sx.-Mousehole

RECEIVED
STATE CORPORATION COMMISSION

JUN 22 1981

Weld plate with number and date

Name of Plugging Contractor Zenith Drilling Co. Liberal, Kansas
Address Liberal, Kansas

STATE OF Oklahoma COUNTY OF Woodward ss.


(employee of owner) or (owner or operator) of the above-described well, being first duly sworn on oath, says: That I have knowledge of the facts, statements, and matters herein contained and the log of the above-described well as filed and that the same are true and correct. So help me God.

(Signature) Robert W. Ward

P.O. Box 249, Woodward, OK 73801

(Address)

Subscribed and sworn to before me this 10th day of June 19 81

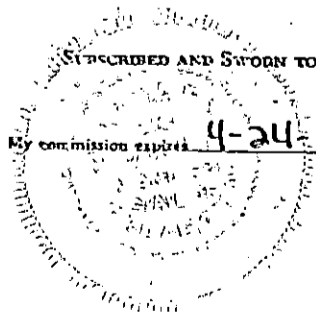

My commission expires 4-24-85

Jandy Juinder

Notary Public.