

15-119-10343-0000

STATE OF KANSAS
STATE CORPORATION COMMISSION

Give All Information Completely
Make Required Affidavit
Mail or Deliver Report to:
Conservation Division
State Corporation Commission
211 No. Broadway
Wichita, Kansas

WELL PLUGGING RECORD

Meade County, Sec. 15 Twp. 34S Rge. (E) 30 (W)

Location as "NE/CNW/SW" or footage from lines NW NE

Lease Owner Thomas & Brewer

Lease Name A. W. Adams "H" Well No. 1

Office Address Box 985 - Liberal, Kansas

Character of Well (completed as Oil, Gas or Dry Hole) Dry Hole

Date well completed 3-1 19 60

Application for plugging filed 2-29 19 60

Application for plugging approved 2-29 19 60


Plugging commenced 3-1 19 60

Plugging completed 3-1 19 60

Reason for abandonment of well or producing formation Dry Hole

If a producing well is abandoned, date of last production 19

Was permission obtained from the Conservation Division or its agents before plugging was commenced? Yes

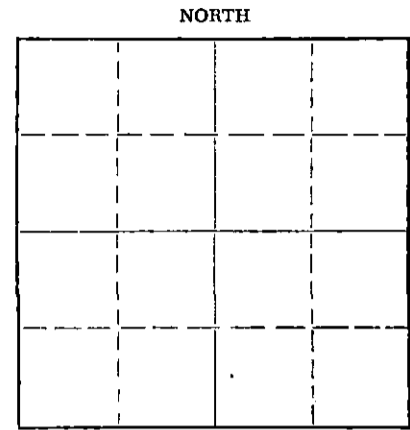

Locate well correctly on above Section Plat

Name of Conservation Agent who supervised plugging of this well Lecamp

Producing formation Depth to top Bottom Total Depth of Well 6000 Feet

Show depth and thickness of all water, oil and gas formations.

OIL, GAS OR WATER RECORDS

CASING RECORD

FORMATION	CONTENT	FROM	TO	SIZE	PUT IN	PULLED OUT
				8 5/8	1193	

Describe in detail the manner in which the well was plugged, indicating where the mud fluid was placed and the method or methods used in introducing it into the hole. If cement or other plugs were used, state the character of same and depth placed, from 35 feet to 35 feet for each plug set.

Plug @ 550' with 1/4 sack hulls, 20 sacks cement; Fill up with heavy mud to 340'. Plug at 340' with 1/4 sack hulls, 20 sacks cement. Heavy mud to 35'. Plug @ 35' with 10 sacks cement to surface.

(If additional description is necessary, use BACK of this sheet)

Name of Plugging Contractor Bennett & Roberts

Address Russell, Kansas

STATE OF KANSAS, COUNTY OF SEWARD, ss.

Glenn F. Thomas (employee of owner) or (owner or operator) of the above-described well, being first duly sworn on oath, says: That I have knowledge of the facts, statements, and matters herein contained and the log of the above-described well as filed and that the same are true and correct. So help me God.

(Signature) [Signature] Box 985 - Liberal, Kansas (Address)

SUBSCRIBED AND SWORN TO before me this 7th day of March, 19 60

My commission expires November 5, 1962

[Signature] Notary Public.



R

THOMAS & BREWER
ADAMS H#1

C/NW NE of Section 15-35-30
Meade County, Kansas

RTD 6000
Commenced 2/2/60
Completed 3/1/60

CONTRACTOR: Bennett & Roberts Drilling Co.

Set 1193' of 8 5/8" w/600 sx cmt.

Sand & Gravel	240'
Red Bed & Sand	480
Red Bed	1060
Red Bed w/Anhydrite Shells	1179
Anhydrite	1250
Red Bed & Anhydrite Streaks	1280
Red Bed & Shale	1365
Shale & Shells	1989
Shale & Lime	2379
Lime	3145
Lime & Shale	3336
Chalky Lime	3582
Lime	3765
Shale	4014
Shale & Lime	4112
Shale	4185
Shale & Lime	4280
Lime	5772
Lime & Sand	5795
Lime	6000

RECEIVED
STATE CORPORATION COMMISSION
MAR 18 1960
CONSERVATION DIVISION
Wichita, Kansas

STATE OF KANSAS)
RUSSELL COUNTY) SS.

I hereby certify that the above information is correct to
the best of my knowledge.

BENNETT & ROBERTS DRILLING CO.

By *J. Lee Marshall*

Subscribed and sworn to before me this 7th day of March, 1960

Charles Hummel
Notary Public

My Commission Expires 6/17/62