

STATE OF KANSAS  
STATE CORPORATION COMMISSION

Form CP-4


Give All Information Completely  
Make Required Affidavit  
Mail or Deliver Report to:  
Conservation Division  
State Corporation Commission  
212 No. Market  
Wichita, Kansas

WELL PLUGGING RECORD

Meade County, Sec. 13 Twp. 35S Rge. 30W (E) (W)

Location as "NE/CNWxSWx" or footage from lines 660' from S & W Lines  
Lease Owner Underwood Oil Company, Inc.  
Lease Name Jessie S. Adams et al "B" Lease Well No. 5-B  
Office Address 420 Oil & Gas Bldg. - Wichita Falls, Texas 76301  
Character of Well (completed as Oil, Gas or Dry Hole) Dry  
Date well completed June 19, 19 71  
Application for plugging filed Same 19  
Application for plugging approved Same 19  
Plugging commenced Same 19  
Plugging completed Same 19  
Reason for abandonment of well or producing formation Dry

NORTH

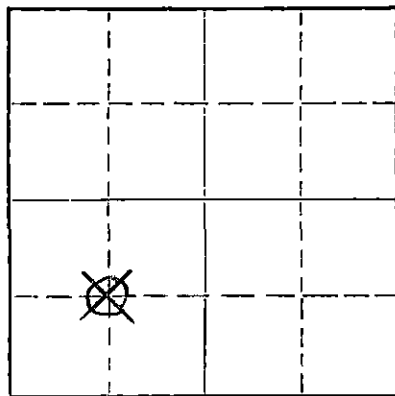

Locate well correctly on above Section Plat

If a producing well is abandoned, date of last production None 19  
Was permission obtained from the Conservation Division or its agents before plugging was commenced? Yes

Name of Conservation Agent who supervised plugging of this well E. Eves Box F-Sublette, Kansas  
Producing formation None Depth to top Bottom Total Depth of Well 6300 Feet  
Show depth and thickness of all water, oil and gas formations.

OIL, GAS OR WATER RECORDS

CASING RECORD

FORMATION	CONTENT	FROM	TD	SIZE	PUT IN	PULLED OUT
Shale & silt-surface		0	1495	8-5/8		None
Cemented 675 sacks						

RECEIVED  
STATE CORPORATION COMMISSION  
JUL 12 1971  
CONSERVATION DIVISION  
Wichita, Kansas

Describe in detail the manner in which the well was plugged, indicating where the mud fluid was placed and the method or methods used in introducing it into the hole. If cement or other plugs were used, state the character of same and depth placed, from feet to feet for each plug set.

35 sacks cement 1475'  
15 sacks cement 45'

Plugging instructions given by Mr. Eves, Kansas Corp. Commission to F W A Drilling Co., Inc..

Name of Plugging Contractor F. W. A Drilling Co., Inc. (If additional description is necessary, use BACK of this sheet)  
Address Oil & Gas Bldg. - Wichita Falls, Texas 76301

STATE OF Texas, COUNTY OF Wichita, ss.  
R. Clay Underwood (employee of owner) or (owner or operator) of the above-described well, being first duly sworn on oath, says: That I have knowledge of the facts, statements, and matters herein contained and the log of the above-described well as filed and that the same are true and correct. So help me God.

(Signature) [Signature]  
420 Oil & Gas Bldg. - Wichita Falls, Texas 76301 (Address)

SUBSCRIBED AND SWORN TO before me this 6th day of July, 19 71

My commission expires June 1, 1973

[Signature] Edna M. Dameron  
Notary Public.

WELL RECORD

Underwood Oil Company, Inc.  
 Jessie S. Adams et al Well No. 5-B  
 Sec. 13-T35S-R30W, Meade County, Kansas

RECEIVED  
 STATE CORPORATION COMMISSION  
 JUL 12 1971  
 CONSERVATION DIVISION  
 Wichita, Kansas


Ground Elevation - Est. 2365'

Drilling Contractor: F W. A Drilling Co., Inc.  
 Oil & Gas Bldg.  
 Wichita Falls, Texas 76301

Well Commenced: 5-30-71 Casing Record 1495' 8-5/8"  
 Well Completed: 6-19-71 675 sacks cement

Formation Log

Sand and shale	0	2822	
Shale and anhydrite	2822	4180	Council Grove
Shale and anhydrite	4180	4398	Toronto
Lime/Dolemite	4398	5122	Lansing
Dolemite/Shale	5122	5720	Marmaton
Sand/Shale	5720	5872	Morrow
Lime/Shale	5872	6023	Chester
Lime	6023	6204	St. Genevieve
Lime	6204	6300	T. D.

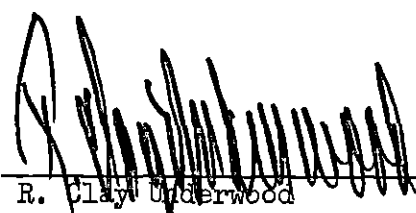

R. Clay Underwood

July 6, 1971