

15-119-30077-0000
SP


STATE OF KANSAS
STATE CORPORATION COMMISSION

WELL PLUGGING RECORD

Give All Information Completely
Make Required Affidavit
Mail or Deliver Report to:
Conservation Division
State Corporation Commission
211 No. Broadway
Wichita, Kansas

Meade County. Sec. 13 Twp 35 S Rge. (E) 30 (W)
Location as "NE/CNW/SW" or footage from lines SE/4 NE/4
Lease Owner AN-SON CORPORATION
Lease Name RAYMOND ADAMS Well No. 1
Office Address 3814 North Santa Fe, Okla. City, Okla.
Character of Well (completed as Oil, Gas or Dry Hole) Dry Hole
Date well completed January 11 19 66
Application for plugging filed January 12 19 66
Application for plugging approved January 13 19 66
Plugging commenced January 12 19 66
Plugging completed January 13 19 66
Reason for abandonment of well or producing formation Dry Hole

NORTH

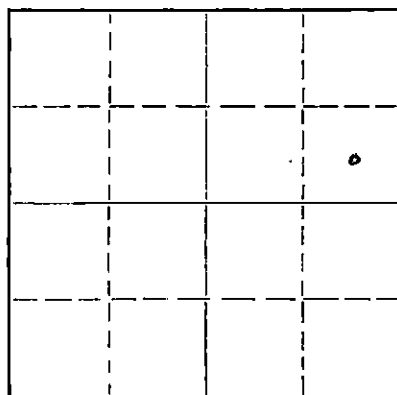

Locate well correctly on above
Section Plat

If a producing well is abandoned, date of last production 19
Was permission obtained from the Conservation Division or its agents before plugging was commenced? Yes

Name of Conservation Agent who supervised plugging of this well Hugh Scott
Producing formation Depth to top Bottom Total Depth of Well 6351 Feet
Show depth and thickness of all water, oil and gas formations.

OIL, GAS OR WATER RECORDS

CASING RECORD

FORMATION	CONTENT	FROM	TO	SIZE	PUT IN	PULLED OUT
St. Louis		6140	6351	8-5/8	1503'	None

Describe in detail the manner in which the well was plugged, indicating where the mud fluid was placed and the method or methods used in introducing it into the hole. If cement or other plugs were used, state the character of same and depth placed, from feet to feet for each plug set.

Placed 35 sacks cement plug from 600' to 700'. Placed 15 sacks cement plug from 0' to 45'.
Welded steel plate to top of surface.

RECEIVED
STATE CORPORATION COMMISSION

JAN 28 1966

CONSERVATION DIVISION
Wichita, Kansas

(If additional description is necessary, use BACK of this sheet)

Name of Plugging Contractor
Address

STATE OF OKLAHOMA, COUNTY OF OKLAHOMA, ss.
Raymond Price (employee of owner) or (owner or operator) of the above-described well, being first duly sworn on oath, says: That I have knowledge of the facts, statements, and matters herein contained and the log of the above-described well as filed and that the same are true and correct. So help me God.

(Signature) Raymond Price
3814 N. Santa Fe - Oklahoma City, Oklahoma
(Address)

SUBSCRIBED AND SWORN TO before me this 26th day of January, 19 66

Virginia J. Quillen
Notary Public.

My commission expires January 28, 1969



1980' S. N. LINE, 900' W. E. LINE
SECTION 13-35S-30W
MEADE COUNTY, KANSAS

ADAMS WELL NO. 1

CONTRACTORS: THE R. W. RINE DRILLING COMPANY

STARTED: DECEMBER 22, 1965

COMPLETED: JANUARY 12, 1966

L O G

Sand	0'	-	142'
Red Bed & Gypsum	142'	-	1503'
Shale & Anhydrite	1503'	-	2045'
Lime & Shale	2045'	-	2294'
Lime	2294'	-	2585'
Lime & Shale	2585'	-	3755'
Shale	3755'	-	4268'
Lime & Shale	4268'	-	4655'
Lime	4655'	-	4920'
Lime & Shale	4920'	-	5015'
Lime	5015'	-	5045'
Lime & Shale	5045'	-	5128'
Lime	5128'	-	5497'
Lime & Shale	5497'	-	5565'
Lime	5565'	-	5685'
Lime & Shale	5685'	-	5848'
Lime	5848'	-	5946'
Lime & Shale	5946'	-	6010'
Lime	6010'	-	6020'
Lime & Shale	6020'	-	6068'
Lime	6068'	-	6347'

8 5/8 @ 1503' w/700 sx poz + 200 cm.

RECEIVED
STATE CORPORATION COMMISSION

JAN 28 1966

CONSTRUCTION DIVISION
Wichita, Kansas

Totco @ 6010', 1/4"


D & A; 35 sx cement Plug @ 700'-600';
15 sx from 45' below G.L. to 3' below
G.L.

STATE OF KANSAS)
COUNTY OF SEDGWICK) ss

I, R. M. Green, do hereby certify that the above is a true and accurate log of the Adams Well No. 1, located 1980' S. N. Line, 900' W.E. Line of Section 13-35S-30W, Meade County, Kansas.


R. M. Green, Secretary-Treasurer

Subscribed and sworn to before me this 20th day of January, 1966.

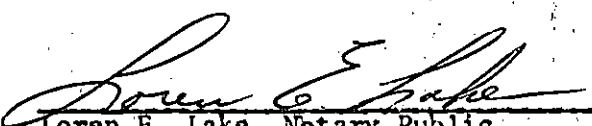
Loren E. Lake, Notary Public

My Commission Expires: 6/14/66