

STATE OF KANSAS
STATE CORPORATION COMMISSION

Form CP-4

WELL PLUGGING RECORD

Give All Information Completely
Make Required Affidavit
Mail or Deliver Report to:
Conservation Division
State Corporation Commission
212 No. Market
Wichita, Kansas

Mead County. Sec. 11 Twp. 35S Rge. (E) 30 (W)

Location as "NE/CNW/SW" or footage from lines SE NE

Lease Owner Cleary Petroleum, Inc.

Lease Name Adams "K" Well No. 1

Office Address 310 Kermac Bldg., Okla. City, Okla. 73100

Character of Well (completed as Oil, Gas or Dry Hole) Dry

Date well completed 11-18 19 68

Application for plugging filed 19

Application for plugging approved 19


Plugging commenced 11-13 19 68

Plugging completed 11-18 19 68

Reason for abandonment of well or producing formation

If a producing well is abandoned, date of last production 19

Was permission obtained from the Conservation Division or its agents before plugging was commenced? Yes

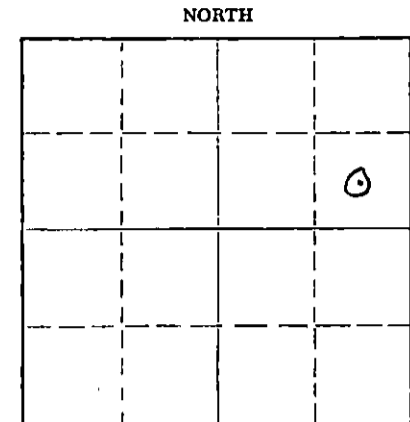

Locate well correctly on above Section Plat

Name of Conservation Agent who supervised plugging of this well Ed Eves

Producing formation Depth to top Bottom Total Depth of Well Feet

Show depth and thickness of all water, oil and gas formations.

OIL, GAS OR WATER RECORDS

CASING RECORD

FORMATION	CONTENT	FROM	TO	SIZE	PUT IN	PULLED OUT
				5 1/2	5826	2524

Describe in detail the manner in which the well was plugged, indicating where the mud fluid was placed and the method or methods used in introducing it into the hole. If cement or other plugs were used, state the character of same and depth placed, from feet to feet for each plug set.

Spotted 20 sack cement plug by pump method displaced with mud to 5500', shot off pipe at 2512', pulled pipe to 1800', spotted 35 sack cement plug from 1700' to 1800'.

RECEIVED
STATE CORPORATION COMMISSION
DEC 27 1968
CONSERVATION DIVISION
Wichita, Kansas

RECEIVED
STATE CORPORATION COMMISSION
DEC 16 1968
CONSERVATION DIVISION
Wichita, Kansas

(If additional description is necessary, use BACK of this sheet)

Name of Plugging Contractor Lillard Casing Pulling, Inc.
Address P. O. Box 962, Woodward, Oklahoma 73801

STATE OF Oklahoma, COUNTY OF Oklahoma, ss.
Joe B. Lewis (employee of owner) or (owner or operator) of the above-described

well, being first duly sworn on oath, says: That I have knowledge of the facts, statements, and matters herein contained and the log of the above-described well as filed and that the same are true and correct. So help me God.

(Signature) Joe B. Lewis
Joe B. Lewis, Operations Manager
Cleary Petroleum Corporation
310 Kermac Building, Oklahoma City, Oklahoma 73102

SUBSCRIBED AND SWORN TO before me this 19 day of December, 1968

Phyllis J. Taylor
Notary Public.

My commission expires October 16, 1970