


STATE OF KANSAS
STATE CORPORATION COMMISSION

Form CP-4

WELL PLUGGING RECORD

Give All Information Completely
Make Required Affidavit
Mail or Deliver Report to:
Conservation Division
State Corporation Commission
212 No. Market
Wichita, Kansas 67202

NORTH

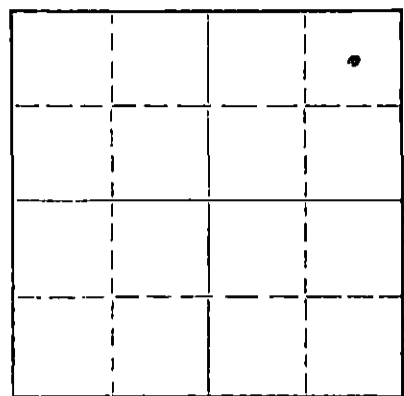

Locate well correctly on above
Section Plat

Meade County, Sec. 10 Twp. 35S Rge. 30 ~~XX~~ (W)
Location as "NE/CNW&SW" or footage from lines C NE/4 NE/4
Lease Owner Cities Service Oil Company
Lease Name Adams "O" Well No. 1
Office Address Box 1098, Liberal, Kansas 67901
Character of Well (completed as Oil, Gas or Dry Hole) Dry Hole
Date well completed 6-26 19 70
Application for plugging filed 6-26 19 70
Application for plugging approved 6-26 19 70
Plugging commenced 6-26 19 70
Plugging completed 6-26 19 70
Reason for abandonment of well or producing formation Dry Hole

If a producing well is abandoned, date of last production 19
Was permission obtained from the Conservation Division or its agents before plugging was commenced? Yes

Name of Conservation Agent who supervised plugging of this well E. J. Eves
Producing formation St. Louis Depth to top 6259 Bottom 6265 Total Depth of Well 6300 Feet
Show depth and thickness of all water, oil and gas formations.

OIL, GAS OR WATER RECORDS CASING RECORD

FORMATION	CONTENT	FROM	TO	SIZE	PUT IN	PULLED OUT
Lansing	Salt Water	4995	5061	8-5/8"	1489'	0
Marmaton	Salt Water	5284	5748			
Morrow	Salt Water	5748	5845			
Chester	Salt Water	5903	5987			
St. Genevieve	Salt Water	6147	6228			
St. Louis	Salt Water	6259	6265			

Describe in detail the manner in which the well was plugged, indicating where the mud fluid was placed and the method or methods used in introducing it into the hole. If cement or other plugs were used, state the character of same and depth placed, from feet to feet for each plug set.

30 sacks cement plug from 6300' to 6200'
Mud plug from 6200' to 1085'
50 sacks cement plug from 1085' to 945'
Mud plug from 945' to 42'
15 sacks cement plug from 42' to surface.

RECEIVED
STATE CORPORATION COMMISSION
JUL 6 1970
CONSERVATION DIVISION
Wichita, Kansas

(If additional description is necessary, use BACK of this sheet)
Name of Plugging Contractor Halliburton
Address Liberal, Kansas

STATE OF KANSAS, COUNTY OF SEWARD, ss.
R. L. Higginbottom (employee of owner) or (owner or operator) of the above-described well, being first duly sworn on oath, says: That I have knowledge of the facts, statements, and matters herein contained and the log of the above-described well as filed and that the same are true and correct. So help me God.

(Signature) *R. L. Higginbottom*
Box 1098, Liberal, Kansas 67901
(Address)

SUBSCRIBED AND SWORN TO before me this 2nd day of July, 1970

My commission expires 5-23-73

J. T. Mabrey
J. T. Mabrey Notary Public.

ROTARY DRILLING LOG


LEASE:	Adams "O" #1	CASING:	8-5/8" @ 1489'/800
OWNER:	Cities Service Oil Co.	COMMENCE:	6-14-70
CONTRACTOR:	F.W.A. Drilling Co.	COMPLETE:	6-26-70
LOCATION:	C NE NE, Sec. 10-35S-30W Meade County, Kansas		

Sand & Red Bed	0' - 493'
Red Bed & Anhydrite	493' - 1020'
Red Bed	1020' - 1482'
Anhydrite	1482' - 1489'
Shale & Anhydrite	1489' - 2175'
Anhydrite, Shale, & Lime	2175' - 2455'
Dolomite	2455' - 3579'
Lime & Shale	3579' - 4752'
Lime	4752' - 6300'

We certify that the above log is true and correct to the best of our knowledge and belief.

CITIES SERVICE OIL COMPANY

By

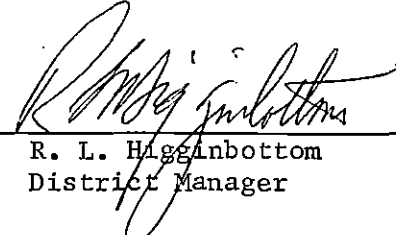
 R. L. Hagganbottom
 District Manager

RECEIVED
 STATE CORPORATION COMMISSION
 JUL 6 1970
 CONSERVATION DIVISION
 Wichita, Kansas