

15-119-10341-0000

STATE OF KANSAS
STATE CORPORATION COMMISSION

Form CP-4


Give All Information Completely
Make Required Affidavit
Mail or Deliver Report to:
Conservation Division
State Corporation Commission
212 No. Market
Wichita, Kansas

WELL PLUGGING RECORD

Meade County. Sec. 9 Twp. 35S Rge. 30W (E) (W)

Location as "NE/CNW/SW" or footage from lines C NE NE
Lease Owner Thomas-Brewer
Lease Name Adams F Well No. 1
Office Address Box 985, Liberal, Kansas
Character of Well (completed as Oil, Gas or Dry Hole) D & A
Date well completed October 28, 1959 19
Application for plugging filed 19
Application for plugging approved 19
Plugging commenced October 28, 1959 19
Plugging completed October 28, 1959 19
Reason for abandonment of well or producing formation

NORTH

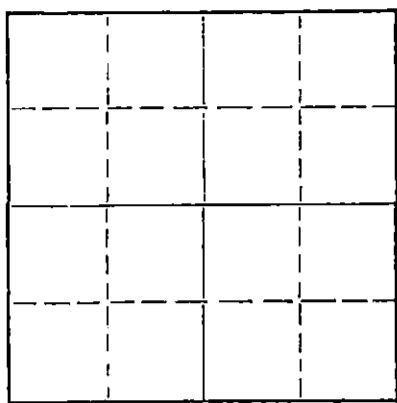

Locate well correctly on above Section Flat

If a producing well is abandoned, date of last production 19
Was permission obtained from the Conservation Division or its agents before plugging was commenced? Yes

Name of Conservation Agent who supervised plugging of this well Mr. Rives
Producing formation Depth to top Bottom Total Depth of Well 6100 Feet
Show depth and thickness of all water, oil and gas formations.

OIL, GAS OR WATER RECORDS CASING RECORD

FORMATION	CONTENT	FROM	TO	SIZE	PUT IN	PULLED OUT

Describe in detail the manner in which the well was plugged, indicating where the mud fluid was placed and the method or methods used in introducing it into the hole. If cement or other plugs were used, state the character of same and depth placed, from feet to feet for each plug set.

8 5/8 S.P. 1153 circulated with cement. Hole filled with heavy mud to 600' Set plug Displace 35' sacks cement through Drill pipe. Mud to 40' Set plug Cemented to base of cellar. Cement pump ed by Sun Cementing Company

RECEIVED
STATE CORPORATION COMMISSION
MAR 14 1966
CONSERVATION DIVISION
Wichita, Kansas

(If additional description is necessary, use BACK of this sheet)

Name of Plugging Contractor Bennet - Roberts Drilling Company
Address Russell, Kansas

STATE OF Kansas COUNTY OF Seward, ss.
Devin P. Buck (employee of owner) or (owner or operator) of the above-described

well, being first duly sworn on oath, says: That I have knowledge of the facts, statements, and matters herein contained and the log of the above-described well as filed and that the same are true and correct. So help me God

(Signature) Devin P. Buck

(Address)

SUBSCRIBED AND SWORN TO before me this 11th day of March, 1966

Marlene Keating
Notary Public.

My commission expires 11-5-66

MARLENE KEATING
NOTARY PUBLIC, SEWARD COUNTY, KANS.
MY COMMISSION EXPIRES NOV. 5, 1966

15-119-10341-0000


WELL LOG BUREAU—KANSAS GEOLOGICAL SOCIETY
508 East Murdock, Wichita, Kansas

Company- THOMAS & BREWER
Farm- Adam "F" No. 1

SEC. 9 T. 35 R. 30W
C NE NE

Total Depth. 6096'
Comm. 10-2-59 Comp. 10-28-59
Shot or Treated.
Contractor. Bennett & Roberts Drilling Co.
Issued. 8-3-63

County Meade
KANSAS

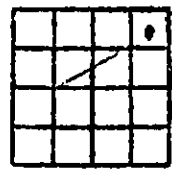

CASING:
8 5/8" 1153' cem w/600 sx.

Elevation. 2438' RB

Production. Dry

Figures Indicate Bottom of Formations.

sand & clay	318
redbed & sand	1128
Anhydrite	1153
redbed & sand	1488
redbed & shale	1572
shale & shells	1700
shale & lime	2346
lime	3445
chalky lime	3619
lime	3698
lime & shale	3990
shale	4350
lime	5363
lime & shale	5423
lime	5530
lime & shale	6015
lime	6055
lime & shale	6094
lime	6096 RTD
Total Depth	

TOPS:	
Morrow Shale	5671
Chester	5810

RECEIVED
STATE CORPORATION COMMISSION

FEB 22 1966

Wichita, Kans