


STATE OF KANSAS
STATE CORPORATION COMMISSION
CONSERVATION DIVISION
P. O. BOX 17027
WICHITA, KANSAS 67217

FORM CP-4

WELL PLUGGING RECORD

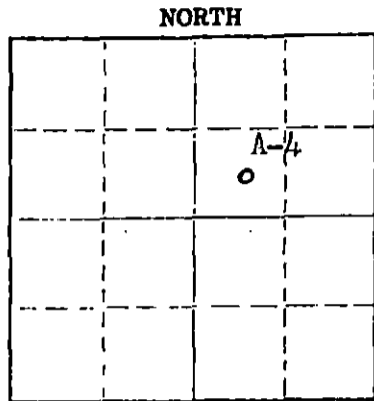

Locate well correctly on above Section Plot

Meade County, Sec. 8 Twp. 35S Rge. 30 (E) (W) X
Location as "NE/CNW/SE/SW" or footage from lines 19808 FNL & FWL
Lease Owner R. Clay Underwood
Lease Name Jessie S. Adams Well No. A-3
Office Address Box 1068 Liberal, Kansas 67901
Character of Well (completed as Oil, Gas or Dry Hole) Dry Hole
Date well completed 1-9-1976
Application for plugging filed 1-9-1976
Application for plugging approved 1-20-1976
Plugging commenced 1-20-1976
Plugging completed 1-22-1976
Reason for abandonment of well or producing formation dry hole

If a producing well is abandoned, date of last production none 10
Was permission obtained from the Conservation Division or its agents before plugging was commenced? Yes

Name of Conservation Agent who supervised plugging of this well Clarence Thomas
Producing formation none Depth to top Bottom Total Depth of Well 3020 Feet
Show depth and thickness of all water, oil and gas formations.

OIL, GAS OR WATER RECORDS

CASING RECORD

| FORMATION | CONTENT | FROM | TO | SIZE | PUT IN | PULLED OUT |
|-----------|---------|------|----|-------|--------|------------|
| | | | | 8 5/8 | 1442 | none |
| | | | | 4 1/2 | 3020 | 2010 |
| | | | | | | |
| | | | | | | |
| | | | | | | |
| | | | | | | |
| | | | | | | |

Describe in detail the manner in which the well was plugged, indicating where the mud fluid was placed and the method or methods used in introducing it into the hole. If cement or other plugs were used, state the character of same and depth placed from feet to feet for each plug set.

Pump 10 sks. of cement & 1 sk. hulls to 2800 ft.
Pump 40 sks. of cement to 1400 ft.
Put 10 sks. of cement from 33 to 3 ft.

RECEIVED
STATE CORPORATION COMMISSION

FEB 9 1976

CONSERVATION DIVISION
Wichita, Kansas

(If additional description is necessary, use BACK of this sheet)
Name of Plugging Contractor Sargents Casing Pulling Service Kansas No. 511
Address Box 506 Liberal, Kansas 67901

STATE OF TEXAS COUNTY OF WICHITA SS.
R. CLAY UNDERWOOD (employee of owner) or (owner or operator) of the above-described well, being first duly sworn on oath, says: That I have knowledge of the facts, statements, and matters herein contained and the log of the above-described well as filed and that the same are true and correct. So help me God.

(Signature) R. CLAY UNDERWOOD Owner

420 Oil & Gas Bldg. Wichita Falls, Texas 76301

SUBSCRIBED AND SWORN TO before me this 6 day of February, 1976

My commission expires June 1, 1977

Betty Wolford
Notary Public.

15-119-20119-0000

Well Log

Company Underwood Oil Co.

Sec. 8 T.35S R. 30W

Contractor Leben Drilling Inc.

Loc. C SW NE

Farm J.S. Adams A-3

County Seward


Total Depth 3060'

Casing 8 5/8" - 6505 ft

Commenced 11-1-72

Production 4 1/2" - 200 SPM

Completed 11-7-72

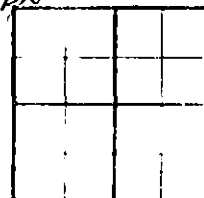

Figures Indicate Bottom of Formations

| | | | |
|-------|---|-------|----------------|
| 0' | - | 320' | Sd |
| 320' | - | 980' | Red Bed & Sh |
| 980' | - | 1415' | Red Bed & Sd |
| 1415' | - | 1440' | Red Bed & Anhy |
| 1440' | - | 1660' | Red Bed |
| 1660' | - | 2085' | Red Bed & Sh |
| 2085' | - | 2315' | Anhy - Sh |
| 2315' | - | 2440' | Sh & Lm |
| 2440' | - | 3060' | Lm & Sh |
| | | 3060' | R.T.D. |

State of Kansas

SS

County of Sedgwick

I, Leslie Kite of Leben Drilling, Inc. upon oath state that the above and foregoing is a true and correct copy of the log of the J.S. Adams A-3 Well.

Leslie Kite

Subscribed and sworn to before me this

16th

day of November, 1972.

My Commission Expires:

March 4, 1976

[Signature]

