


Give All Information Completely  
Make Required Affidavit  
Mail or Deliver Report to:  
Conservation Division  
State Corporation Commission  
212 No. Market  
Wichita, Kansas

WELL PLUGGING RECORD

Meade County, Sec. 7 Twp. 35S Rge. (E) 30 (W) 660' from W. & S. Lines

Location as "NE/CNW/SW" or footage from lines  
Lease Owner Underwood Oil Co., Inc.  
Lease Name Jessie S. Adams et al Well No. 2-A  
Office Address 420 Oil & Gas Bldg. - Wichita Falls, Texas 76301  
Character of Well (completed as Oil, Gas or Dry Hole) Dry  
Date well completed April 27, 19 71  
Application for plugging filed Same 19  
Application for plugging approved Same 19  
Plugging commenced April 27, 19 71  
Plugging completed April 27, 19 71  
Reason for abandonment of well or producing formation Dry Hole

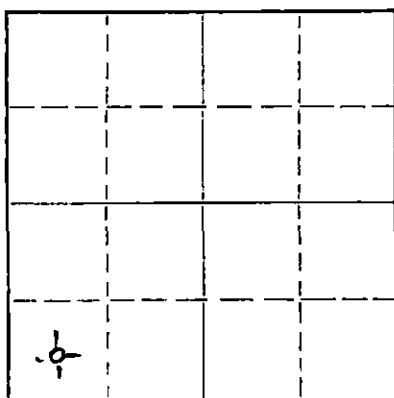

Locate well correctly on above Section Plat

If a producing well is abandoned, date of last production 19  
Was permission obtained from the Conservation Division or its agents before plugging was commenced? Yes

Name of Conservation Agent who supervised plugging of this well E. Eves, Box F, Sublete, Kan.  
Producing formation None Depth to top Bottom Total Depth of Well 4765 Feet  
Show depth and thickness of all water, oil and gas formations.

OIL, GAS OR WATER RECORDS

CASING RECORD

FORMATION	CONTENT	FROM	TO	SIZE	PUT IN	PULLED OUT
Shale & Silt-Surface		0	2110	8 5/8	1469	None
Cemented w/675 sacks						

Describe in detail the manner in which the well was plugged, indicating where the mud fluid was placed and the method or methods used in introducing it into the hole. If cement or other plugs were used, state the character of same and depth placed, from feet to feet for each plug set.

50 sacks cement 1370'  
25 sacks cement at top of 8 5/8" (surface)

Plugging instructions given by Mr. E. Eves, Kansas Corporation  
Commission to FWA Drilling Co., Inc.

RECEIVED  
STATE CORPORATION COMMISSION  
MAY 12 1971  
CONSERVATION DIVISION  
Wichita, Kansas

(If additional description is necessary, use BACK of this sheet)

Name of Plugging Contractor FWA Drilling Co., Inc.  
Address Oil & Gas Bldg. - Wichita Falls, Texas 76301

STATE OF Texas, COUNTY OF Wichita, ss.  
R. Clay Underwood (employee of owner) or (owner or operator) of the above-described well, being first duly sworn on oath, says: That I have knowledge of the facts, statements, and matters herein contained and the log of the above-described well as filed and that the same are true and correct. So help me God.

(Signature) [Signature] Pres.  
420 Oil & Gas Bldg. - Wichita Falls, Texas 76301  
(Address)

SUBSCRIBED AND SWORN to before me this 7th day of May, 19 71

[Signature] Edna M. Dameron  
Notary Public.

My commission expires June 1, 1971

## WELL RECORD

Underwood Oil Company, Inc.  
 Jessie S. Adams et al Well No. 2-A  
 Sec. 7, T35S, R30W, Meade County, Kansas

Ground Elevation: 2654.4 GRD  
 2659.9 KB

Drilling Contractor: FWA Drilling Co., Inc.  
 Wichita Falls, Texas

Well Commenced: 14 April 1971  
 Well Completed: 27 April 1971

Casing Record:  
 8 5/8" @1469' -  
 675 sacks cement

## FORMATION LOG

Sand and shale	0	1853	
Shale and anhydrite	1853	2415	
Lime and anhydrite/shale	2415	2517	Tops
Shale & dolemite	2517	2685	(Wolfcamp 2642)
Lime/dolemite	2685	3775	(Council Grove 3030)
Dolemite and shale	3775	3910	(Toronto 4412)
Shale	3910	4185	(Lansing 4600)
Shale and lime	4185	4560	
Lime	4560	4765	T.D.

Underwood Oil Company, Inc.

  
 R. Gary Underwood, President

May 7, 1971

RECEIVED  
 STATE CORPORATION COMMISSION  
 MAY 12 1971  
 CONSERVATION DIVISION  
 Wichita, Kansas