

STATE OF KANSAS
STATE CORPORATION COMMISSION

WELL PLUGGING RECORD

Give All Information Completely
Make Required Affidavit
Mail or Deliver Report to:
Conservation Division
State Corporation Commission
800 Bitting Building
Wichita, Kansas

Meade County, Sec. 6 Twp. 35 Rge. 30 (E) (W)

Location as "NE/CNW $\frac{1}{4}$ SW $\frac{1}{4}$ " or footage from lines 660' Fm South 1980' Fm East Line

Lease Owner Columbian Fuel Corp

Lease Name A.W. Adams Well No. J-1

Office Address Box 994..Liberal, Kansas

Character of Well (completed as Oil, Gas or Dry Hole) Dry Hole

Date well completed 4-4-52 19__

Application for plugging filed 5-28-52 19__

Application for plugging approved 6-2-52 19__


Plugging commenced 7-1-52 19__

Plugging completed 7-12-52 19__

Reason for abandonment of well or producing formation Dry Hole

If a producing well is abandoned, date of last production 19__

Was permission obtained from the Conservation Division or its agents before plugging was commenced? Yes

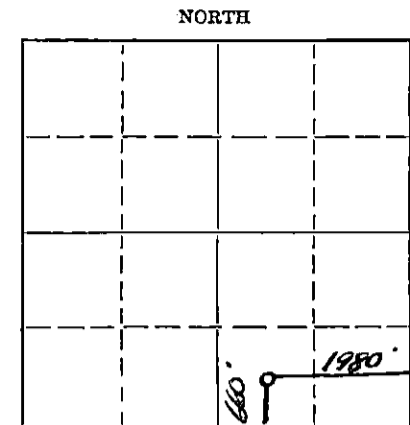

Locate well correctly on above Section Plat

Name of Conservation Agent who supervised plugging of this well R.J. Phillippe

Producing formation _____ Depth to top _____ Bottom _____ Total Depth of Well 6100' Feet

Show depth and thickness of all water, oil and gas formations.

OIL, GAS OR WATER RECORDS

CASING RECORD

Formation	Content	From	To	Size	Put In	Pulled Out
Sand & Shells	Water	0	500'	13 3/8"	513'	0
				8 5/8"	2450'	0
				5 1/2"	5820'	2201'

Describe in detail the manner in which the well was plugged, indicating where the mud fluid was placed and the method or methods used in introducing it into the hole. If cement or other plugs were used, state the character of same and depth placed, from _____ feet to _____ feet for each plug set.

4700' To 300' Mud	5789 - 5730'	50 Sacks Cement
300' - 290' Rock Bridge	5160'	Lane Wells Bridging Plug
290' - 220' 20 Sks. Cement	4870'	Lane Wells Bridging Plug
220' - 95' Mud	4820'	Plastic Plug
95' - 30' Rock Bridge	4730' - 4700'	30 Sacks Cement
30' - 0' Cement		

RECEIVED
STATE CORPORATION COMMISSION
JUL 22 1952
7-22-52
CONSERVATION DIVISION
Wichita, Kansas

(If additional description is necessary, use BACK of this sheet)

Name of Plugging Contractor Barnes & Son..Russell, Kansas

Address _____

STATE OF Kansas COUNTY OF Seward, ss.

Robert Grady, Superintendent (employee of owner) or (owner or operator) of the above-described well, being first duly sworn on oath, says: That I have knowledge of the facts, statements, and matters herein contained and the log of the above-described well as filed and that the same are true and correct. So help me God.

(Signature) Robert Grady

Box 994..Liberal, Kansas
(Address)

SUBSCRIBED AND SWORN TO before me this 15th day of July, 1952

Wallace B. Pedigo
Notary Public.

My commission expires June 4, 1955

FILED
REC 6 135.11300
BOOK PAGE 19 LINE 4

DRILLER'S LOG

Owner: Columbian Fuel Corp.

Elevation:

Contractor: Midwestern Drillers
628 Wright Building
Tulsa 3, Oklahoma

Well Commenced: Feb. 8, 1952

Well Completed: Rotary - Apr. 4, 1952

Lease Name: A. W. Adams #J-1

Total Depth: 6100' RB

Location: SW $\frac{1}{4}$ of SE $\frac{1}{4}$, Sec. 6, T35S,
R30W, Meade County, Kansas

Casing Record: Surface - Set 501' of 12-3/4" Casing
Intermediate - Set 2450' of 8-5/8" Casing with 900 sacks Cement
Production - Set 5820' of 5 1/2" Casing with 400 sacks Cement

<u>FORMATION</u>	<u>DEPTH FROM ROTARY BUSHING</u>
Sand & gravel	400
Red shale & sand	440
Red bed & sand	550
Red bed	644
Red bed & gyp	765
Red bed & sand	950
Shale & sand streaks	1075
Shale & sand	1230
Shale & gyp	1310
Red bed, shale & gyp	1480
Shale & red bed	1550
Red bed & streaks of anhydrite	1680
Shale & anhydrite	1780
Lime, shale & anhydrite	1890
Shale & shells	1980
Shale & anhydrite	2105
Lime & shale	2200
Anhydrite & lime	2360
Lime & anhydrite	2465
Lime	2480
	Run intermediate casing 2450'. Cement did not circulate. Run 500 sacks cement around top of 8-5/8" Casing
Lime	2540
Lime & shale	2655
Lime & anhydrite	2730
Lime	2815
Shale & lime	2915
Lime	3010
Lime & shale	3475
Lime & shale (Box broke off - Dropped pipe)	3593
Shale & lime	3607
Lime & shale	3825
Lime & shale	4200
Lime & shale (Drill Stem Test)	4378
Lime & shale	4395
Lime	4447
Shale & lime	4578
Lime & shale	4672
Lime	4688
Lime & shale	4743
Lime	4803
Shale & lime (Drill Stem Test)	4892
Lime & shale (Drill Stem Test)	4973
Lime	5068
Lime & shale	5165

RECEIVED
STATE CORPORATION COMMISSION

JUN 2 - 1952

(Continued next page)

CONSERVATION DIVISION
PLUGGING
FILE SEC 61-55-302
BOOK PAGE 19-44

DRILLER'S LOG

A. W. Adams #J-1

(Continued)

<u>FORMATION</u>	<u>DEPTH FROM ROTARY BUSHING</u>
Lime	5195
Lime & shale	5270
Lime & shale	5353
Lime & shale (Drill Stem Test)	5442
Lime & shale	5530
Lime & shale	5585
(Cored & reamed)	5611
(Cored & reamed)	5643
Shale & lime	5764
(Cored & reamed)	5789
(Drill Stem Test)	5789 (Packer failed)
(Drill Stem Test)	5789
(Cored & reamed)	5805
Lime & shale	5860
Lime & shale	5937
(Cored & reamed)	5953
Lime & shale (Drill Stem Test)	5973 (Packer failed)
(Drill Stem Test)	5973
Lime & shale (Drill Stem Test)	5980 (Packer failed)
(Drill Stem Test)	5980 (Packer failed)
Lime & shale	6027
Lime & shale	6075
Lime	6100 TD Run Production Casing-5820'

-----0-----

I hereby certify that the above is a true and correct copy of Driller's Log of A. W. Adams #J-1 Well.

Subscribed to and sworn before me this

29th day of April, 1952.

J. W. Wyant
Notary Public

MIDWESTERN DRILLERS

By J. J. Harrison
Partner

My commission expires: 8-12, 1952.

RECEIVED
CORPORATION COMMISSION
JUN 2 - 1952
CONSERVATION DIVISION
Wichita, Kansas

15419-00173-0000

LOG OF WELL

CODE W 2016 Columbian Fuel Corp SHEET _____
 (COMPANY)
 STATE Kansas DISTRICT 72 COUNTY Meade
 LEASE A.W. Adams WELL NO. J-1 SEC. 6 TWP. 35 R. 30
 DATE OF LOG 7-15-52 LOCATION IN SEC. 1980' From East 660' From South Line
 LOCATION MADE 2-7-52 COMM. RIGGING UP 2-12-52 COMM. DRILLING 2-12-52 COMP. DRILLING 4-3-52
 TOTAL DEPTH 6100' ELEVATION 2431.1' Ground STATE PERMIT NO. _____
 DAY DRILLER Junior Glaned NIGHT DRILLER M.E. Rogers CONTRACTOR Midwestern Drillers
 CABLE TOOLS FROM _____ TO _____ ROTARY TOOLS FROM _____ 0 TO _____ 6100'
 OPEN FLOW CAPACITY _____ M. CU. FT. ROCK PRESSURE _____ GASOLINE CONTENT _____ PER M. CU. FT.
 DEPTH IN SAND _____ PRODUCING SANDS AND THICKNESS OF EACH _____
 PRODUCTION FIRST 24 HOURS _____ SETTLED PRODUCTION _____ STARTED PRODUCTION _____
 DATE TUBED _____ SYPHON SET _____ SIZE _____ FEET _____

CASING RECORD

SIZE	WEIGHT	PUT IN WELL		PULLED OUT		LEFT IN WELL		SHOES		PACKERS		
		FEET	IN.	FEET	IN.	FEET	IN.	LENGTH	MAKE	KIND	LENGTH	SET AT
12 3/4"	33.38#	513'				513'						
8 5/8"	32 & 28.5#	2450.36'				2450.36'						
5 1/2"	15.5#	5820'		2201'		3619'						

LINER: STATE SIZE AND WEIGHT _____ WHERE SET _____ FT. AND INS. BLANK _____ FT. AND INS. PERFORATED _____
 HOW PUT TOGETHER _____ COUPLING _____ FLUSH-JOINT _____ INSERTED _____
 REMARKS _____

EQUIPMENT RECORD

TUBING				SUCKER RODS				PUMPING OUTFIT
SIZE	WEIGHT	FEET	IN.	FEET	IN.	SIZE AND KIND	DESCRIPTION, KIND, SIZE, ETC.	

KIND OF SHOT _____ SIZE OF SHOT QUARTS _____ NUMBER OF SHOTS _____
 NUMBER OF SHELLS _____ SIZE OF SHELLS _____ INCHES, DIAMETER _____
 LENGTH OF SHELLS _____ FT. _____ INS. SHOT FURNISHED BY _____ TOP OF SHOT _____
 BOTTOM OF SHOT _____ ANCHOR _____ WELL BRIDGED TO _____
 PRODUCTION BEFORE SHOT _____ PRODUCTION AFTER SHOT _____
 NAME OF SHOOTER _____ SHOT INSPECTED _____ BY _____ (COMPANY EMPLOYEE)
 COMMENCED DRILLING DEEPER _____ COMPLETED DRILLING DEEPER _____
 TOTAL DEPTH _____ PRODUCTION FIRST 24 HOURS _____ SETTLED PRODUCTION _____
 REMARKS: Dry Hole...Plugged By Barnes & Sons Russell, Kansas

NOTE: IF WELL WAS DRY, STATE UNDER REMARKS, WHEN, HOW, AND BY WHOM PLUGGED. STATE UNDER REMARKS ANYTHING OF INTEREST NOT COVERED IN LOG. IF SPACE PROVIDED FOR REMARKS IS NOT SUFFICIENT WRITE ON BOTTOM OF LAST SHEET OF LOG.

PLUGGING
 FILE SEC. 6135R-302
 PAGE 19 LINE 44