


STATE OF KANSAS
STATE CORPORATION COMMISSION

Form CP-4

Give All Information Completely
Make Required Affidavit
Mail or Deliver Report to:
Conservation Division
State Corporation Commission
212 No. Market
Wichita, Kansas

WELL PLUGGING RECORD

NORTH

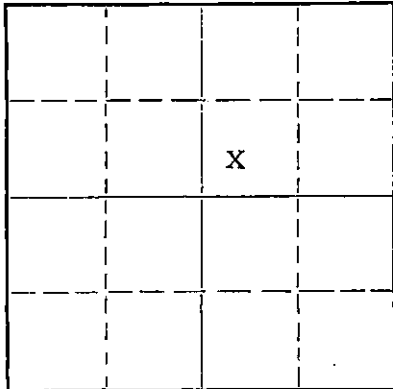

Locate well correctly on above
Section Plat

Seward County. Sec. 3 Twp. 35 Rge. 31W(E) (W)
Location as "NE/CNW/SW" or footage from lines SW NE
Lease Owner Blaik Oil Co.
Lease Name Schlehofer Well No. #1
Office Address Local Federal Bldg., Oklahoma City, Oklahoma
Character of Well (completed as Oil, Gas or Dry Hole) oil
Date well completed December 31, 1969
Application for plugging filed October 5, 1970
Application for plugging approved October 6, 1970
Plugging commenced October 26, 1970
Plugging completed October 27, 1970
Reason for abandonment of well or producing formation Depletion of production

If a producing well is abandoned, date of last production September 1970
Was permission obtained from the Conservation Division or its agents before plugging was commenced? yes

Name of Conservation Agent who supervised plugging of this well Ed Eves
Producing formation Marmaton Depth to top 5233 Bottom _____ Total Depth of Well 5485 Feet
Show depth and thickness of all water, oil and gas formations.

OIL, GAS OR WATER RECORDS				CASING RECORD		
FORMATION	CONTENT	FROM	TO	SIZE	PUT IN	PULLED OUT
				4 1/2"	5359	3063
				8-5/8"	1412	none

Describe in detail the manner in which the well was plugged, indicating where the mud fluid was placed and the method or methods used in introducing it into the hole. If cement or other plugs were used, state the character of same and depth placed, from _____ feet to _____ feet for each plug set.

Spotted 15 sack cement plug by pump method displaced with mud to 5,000', shot off pipe at 3,006', pulled pipe to 1100', spotted 50 sack cement plug from 1100' to 950', spotted 10 sack cement plug from surface to 30', welded cap on top.

RECEIVED
STATE CORPORATION COMMISSION
NOV 20 1970
CONSERVATION DIVISION
Wichita, Kansas

(If additional description is necessary, use BACK of this sheet)
Name of Plugging Contractor Lillard Casing Pulling, Inc.
Address P. O. Box 962, Woodward, Oklahoma

STATE OF Oklahoma COUNTY OF Oklahoma, ss.
Hilde Roberts, Production Secretary (employee of owner) or (owner or operator) of the above-described well, being first duly sworn on oath, says: That I have knowledge of the facts, statements, and matters herein contained and the log of the above-described well as filed and that the same are true and correct. So help me God.

(Signature) Hilde Roberts
203 Park Avenue, Oklahoma City, Oklahoma 73102
(Address)

SUBSCRIBED AND SWORN TO before me this 2 day of November, 19 70

My commission expires 12/7/71
Mary F. Yount Notary Public.