

15-175-10189-0000

STATE OF KANSAS
STATE CORPORATION COMMISSION

WELL PLUGGING RECORD

Give All Information Completely
Make Required Affidavit
Mail or Deliver Report to:
Conservation Division
State Corporation Commission
800 Bittling Building
Wichita, Kansas

Seward County, Sec. 11 Twp. 35 Rge. 32 (S) (W)

Location as "NE/CNW $\frac{1}{4}$ SW $\frac{1}{4}$ " or footage from lines NW SE 1350 from S & 660 From West

Lease Owner Ted R. Lofland

Lease Name Weiland Well No. 1

Office Address Liberal, Kansas. R.F.D #2

Character of Well (completed as Oil, Gas or Dry Hole) Dry

Date well completed February, 25 1952

Application for plugging filed 19

Application for plugging approved 19


Plugging commenced February, 25 1952

Plugging completed May, 10 1952

Reason for abandonment of well or producing formation Dry hole

If a producing well is abandoned, date of last production 19

Was permission obtained from the Conservation Division or its agents before plugging was commenced? Yes

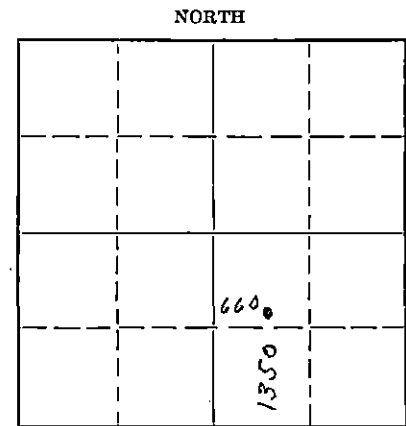

Locate well correctly on above Section Plat

Name of Conservation Agent who supervised plugging of this well R. J. Phillippe, Liberal, Kansas

Producing formation Depth to top Bottom Total Depth of Well 7561 Feet

Show depth and thickness of all water, oil and gas formations.

OIL, GAS OR WATER RECORDS

CASING RECORD

Formation	Content	From	To	Size	Put In	Pulled Out
				13 3/8	600'	none
				9 5/8	2400'	490'

Describe in detail the manner in which the well was plugged, indicating where the mud fluid was placed and the method or methods used in introducing it into the hole. If cement or other plugs were used, state the character of same and depth placed, from feet to feet for each plug set.

Hole full of mud
7561 to 6350 Heavy mud
6350 to 6250 Cement (25 sacks)
6250 to 6100 Heavy mud
6100 to 5900 Cement (.25 sacks)
5900 to 5600 Heavy mud
5600 to 5500 Cement (25 sacks) Set 60 days
5500 to 2400 Heavy mud
2400 to 2310 Cement (25 Sacks)
2310 to 1095 Heavy mud
1095 to 511 Heavy mud, shot off 9 5/8 pipe at 490 feet.
511 to 475 Cement (.30 sacks)
475 to 28 Heavy mud
28 to 5 Cement (.11 sacks)
Cut off pipe and leveled.
All cement was pumped in hole by Halliburton.

(If additional description is necessary, use BACK of this sheet)

Name of Plugging Contractor Unit Drilling Company
Address Bristow, Oklahoma.

STATE OF Kansas, COUNTY OF Seward, ss.
(employee of owner) or (owner or operator) of the above-described well,

being first duly sworn on oath, says: That I have knowledge of the facts, statements, and matters herein contained and the log of the above-described well as filed and that the same are true and correct. So help me God.

(Signature) Ted R. Lofland
(Address) Liberal, Kansas

SUBSCRIBED AND SWORN to before me this 12 day of May, 1952

Alice E. Lofland
Notary Public.

My commission expires June 5, 1953
23-8390-s

PLUGGING
FILE SEC 11 T 35 R 32
BOOK PAGE 47 line 4

RECEIVED
STATE CORPORATION COMMISSION
6-51-20M

MAY 10 1952
51752
CONSERVATION DIVISION
Wichita, Kansas


Weiland Well No. 1
SE/4 Section 11, 35S, 32 W
Seward County, Kansas

J. O. Milson Producers
Liberal, Kansas

Drilling Commenced: December 6, 1951; Completed: February 23, 1952

Formation Record

Surface hole	0	287
Sand	287	525
Red bed	525	764
Red bed & shells	764	1270
Red bed & anhydrite	1270	1555
Shale & shells	1555	1670
Red bed & shale	1670	1696
Shale & anhydrite	1696	1812
Gyp & red bed	1812	1842
Shale & anhydrite	1842	2295
Lime & shale	2295	2366
Lime	2366	2400
Sandy lime	2400	2461
Sand	2461	2553
Lime, shale & sand	2553	2595
Lime & shale streaks	2595	2654
Sandy lime	2654	2719
Lime & shale	2719	2792
Lime	2792	2855
Lime & shale	2855	2921
Lime	2921	3005
Lime & chert	3005	3029
Sandy shale & lime	3029	3062
Lime	3062	3091
Sandy lime	3091	3170
Lime	3170	3370
Broken lime	3370	3428
Lime	3428	3486
Lime & shale	3486	3721
Lime	3721	3734
Shale	3734	3786
Lime	3786	3814
Lime & shale	3814	3937
Shale	3937	4198
Lime & shale	4198	4235
Shale & shells	4235	4336
Shale	4336	4458
Lime & shale	4458	4523
Shale	4523	4545

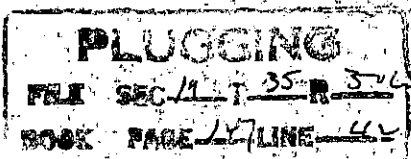

Formation Record (Con't)

Lime	4545	4565
Shale & lime	4565	4642
Lime	4642	4689
Lime & shale	4689	4710
Lime	4710	5149
Lime & shale	5149	5192
Lime	5192	5255
Lime & shale	5255	5284
Lime	5284	5373
Lime & shale	5373	5418
Lime	5418	5421
Lime & shale	5421	5446
Lime	5446	5647
Lime & shale	5647	5946
Sand	5946	5964
Shale & sand	5946	6000
Sand & lime	6000	6051
Shale	6051	6059
Lime	6059	6107
Shale & lime	6107	6157
Sand & shale	6157	6167
Sand & lime	6167	6189
Lime	6189	6217
Sand & shale	6217	6253
Lime	6253	6346
Lime & shale	6346	6378
Lime	6378	6432
Sandy lime	6432	6470
Shale & lime	6470	6516
Shale & lime & sand	6516	6549
Lime	6549	6724
Lime & sand	6724	6737
Lime	6737	6860
Lime & shale	6860	6891
Lime	6891	7277
Lime & chert	7277	7314
Lime	7314	7322
Lime & chert	7322	7339
Lime	7339	7400
Sandy lime	7400	7438
Lime	7438	7490
Cherty lime	7490	7509
Lime & chert	7509	7520
Lime	7520	7561
TOTAL DEPTH		7561

Weiland Well No. 1
J. O. Milson Producers
Liberal, Kansas

Casing Record

13 3/8"	O. D.		607'	casing
9 5/8"	O. D.	36#	2389'	at ground level

Cementing Record

13 3/8"	O. D.	607'	375 sx common	circulated
			15 sx strata-crete	
9 5/8"	O. D.	2389'	900 sx common	circulated