


15-175-00017-0000

STATE OF KANSAS  
STATE CORPORATION COMMISSION

Give All Information Completely  
Make Required Affidavit  
Mail or Deliver Report to:  
Conservation Division  
State Corporation Commission  
211 No. Broadway  
Wichita, Kansas

WELL PLUGGING RECORD

NORTH

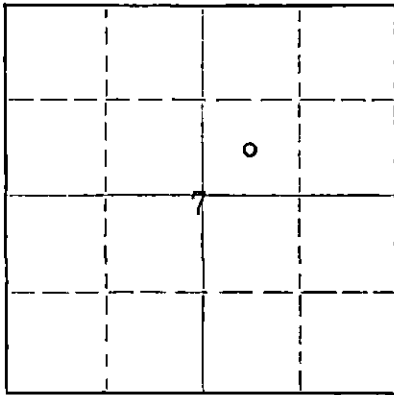

Locate well correctly on above  
Section Plat

Seward County. Sec. 7 Twp. 35S Rge. (E) 32 (W)  
Location as "NE/CNW/SW" or footage from lines. C SW NE  
Lease Owner Shell Oil Company  
Lease Name A. J. BOZARTH Well No. 1  
Office Address P. O. Box 744, Great Bend, Kansas  
Character of Well (completed as Oil, Gas or Dry Hole) Dry Hole  
Date well completed August 31 1957  
Application for plugging filed September 24 1957  
Application for plugging approved (Verbal August 31) September 4 1957  
Plugging commenced August 31 1957  
Plugging completed September 1 1957  
Reason for abandonment of well or producing formation Dry Hole

If a producing well is abandoned, date of last production 19  
Was permission obtained from the Conservation Division or its agents before plugging was commenced? Yes

Name of Conservation Agent who supervised plugging of this well M. A. Rives  
Producing formation Mississippian Depth to top 6096 Bottom Total Depth of Well 6448 Feet  
Show depth and thickness of all water, oil and gas formations.

OIL, GAS OR WATER RECORDS

CASING RECORD

FORMATION	CONTENT	FROM	TO	SIZE	PUT IN	PULLED OUT
Mississippian	Dry	6096	6448	13 3/8"	610'	None
				9 5/8"	2529'	1666'

Describe in detail the manner in which the well was plugged, indicating where the mud fluid was placed and the method or methods used in introducing it into the hole. If cement or other plugs were used, state the character of same and depth placed, from feet to feet for each plug set.

Hole filled with heavy rotary mud.  
Pushed 13 3/8" wooden Halliburton plug in hole to 597' & spotted 35 sax Pozmix cement to 553'.  
Filled hole with heavy rotary mud, set wood plug to 20' & filled hole to base of cellar with 15 sax cement.

(If additional description is necessary, use BACK of this sheet)

Name of Plugging Contractor Midwestern Drillers  
Address Tulsa, Oklahoma

STATE OF KANSAS, COUNTY OF BARTON, ss.  
A. W. Weber (employee of owner) of the above-described well, being first duly sworn on oath, says: That I have knowledge of the facts, statements, and matters herein contained and the log of the above-described well as filed and that the same are true and correct. So help me God.

(Signature) A. W. Weber  
P. O. Box 744, Great Bend, Kansas  
(Address)

SUBSCRIBED AND SWORN TO before me this 24th day of September 1957

My commission expires January 28, 1961

L. M. Byrd, Jr.  
Notary Public.

PLUGGING  
FILE SEC. 7 T. 35 R. 32W  
BOOK PAGE 42 LINE 6

9-25-57  
CONSERVATION DIVISION  
WICHITA, KANSAS

SHELL-A. J. BOZARTH #1  
C SW NE Section 7-35S-32W  
Seward County, Kansas

Casing Record

13 3/8" cem 610 with 400 sax.  
9 5/8" cem 2529 with 275 sax; pulled 1666'.

- 0 - 600 sand & clay
- 655 red bed & shale
- 1400 red bed & gypsum
- 2000 anhydrite
- 2340 anhydrite & shale
- 2530 lime
- 2925 lime & shale
- 3266 lime & shale with chert
- 3640 lime & shale
- 3941 lime, shale & chalk
- 4356 lime, shale & sand
- 4627 shale & lime
- 4720 lime & shale
- 4867 chalky lime & shale
- 5076 lime & shale
- 5130 lime & shale
- 5280 lime
- 6050 lime & shale
- 6095 shale & sand
- 6178 limey shale with sand
- 6448 lime & shale T.D. (RB)

**PLUGGING**  
 FILE SEC. 7 T. 35 R. 32W  
 BOOK PAGE 42 LINE 6