

WELL PLUGGING RECORD

Give All Information Completely  
Make Required Affidavit  
Mail or Deliver Report to:  
Conservation Division  
State Corporation Commission  
212 No. Market  
Wichita, Kansas

Seward County, Sec. 2 Twp. 35S Rge. 32W (E) (W)

Location as "NE/CNW/SW" or footage from lines C SW SW

Lease Owner J. M. Huber Corporation

Lease Name Light Estate "C" Well No. 1

Office Address P. O. Box 831, Borger, Texas 79007

Character of Well (completed as Oil, Gas or Dry Hole) gas

Date well completed 5-4 19 53

Application for plugging filed 12-27 19 68

Application for plugging approved 1-3-69 19


Plugging commenced 1-11 19 69

Plugging completed 1-12 19 69

Reason for abandonment of well or producing formation Uneconomical to produce

If a producing well is abandoned, date of last production 12-31 19 68

Was permission obtained from the Conservation Division or its agents before plugging was commenced? Yes

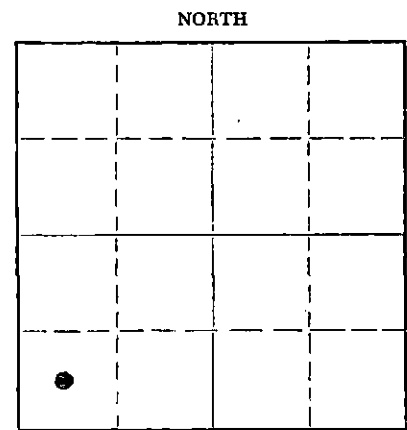

Locate well correctly on above Section Plat

Name of Conservation Agent who supervised plugging of this well E. Eves, Sublett, Kansas

Producing formation Morrow Depth to top 5961 Bottom 5968 Total Depth of Well 6327 Feet

Show depth and thickness of all water, oil and gas formations.

OIL, GAS OR WATER RECORDS

CASING RECORD

FORMATION	CONTENT	FROM	TO	SIZE	PUT IN	PULLED OUT
Red beds		600	891	13-3/8"	620	None
Morrow Sand	gas	5961	5968	9-5/8"	2400	None
				5-1/2"	6040	3029'
		D. V. Tool @ 880' - Cemented w/600 sks + 350 sks				

Describe in detail the manner in which the well was plugged, indicating where the mud fluid was placed and the method or methods used in introducing it into the hole. If cement or other plugs were used, state the character of same and depth placed, from \_\_\_\_\_ feet to \_\_\_\_\_ feet for each plug set.

Mud laden fluid from TD 6327-5968'

Cement plug 5968-5796' (25 sks), displaced w/138 Bbls mud

Mud from 5796-1002'

Cement plug 1002-902' (40 sks), displaced w/22 Bbls mud

Mud from 902-42'

Cement plug 42'-5' (15 sks)

Capped @ surface

RECEIVED  
STATE CORPORATION COMMISSION  
JAN 20 1969  
CONSERVATION DIVISION  
Wichita, Kansas

(If additional description is necessary, use BACK of this sheet)

Name of Plugging Contractor Daco Lease and Well Service  
Address 1700 S. Main St., Borger, Texas 79007

STATE OF TEXAS, COUNTY OF HUTCHINSON, ss.  
David L. Headstream (employee of owner) or (owner or operator) of the above-described

well, being first duly sworn on oath, says: That I have knowledge of the facts, statements, and matters herein contained and the log of the above-described well as filed and that the same are true and correct. So help me God.

(Signature) David L. Headstream  
P. O. Box 831, Borger, Texas 79007  
(Address)

SUBSCRIBED AND SWORN to before me this 17th day of January, 19 69

My Commission Expires June 1st, 1969

My commission expires \_\_\_\_\_

Meryle M. Chambless  
Notary Public.

Meryle M. Chambless  
Notary Public  
in & for Hutchinson County, Texas

DRILLERS' LOG

E

J.M. Huber #1 Light Estate "C"  
Cen SW/4 of SW/4  
Sec 2, Twp 35S, Rge 32W

RECEIVED  
STATE CORPORATION COMMISSION  
DEC 30 1968  
CONSERVATION DIVISION  
Wichita, Kansas

<u>FORMATION</u>	<u>DEPTH</u>
Sand and clay	0-215'
Shells and clay	215-600'
Redbed	600-891'
Redbed and gyp and shells	891-1447'
Shale and gyp	1447-1639'
Anhydrite and shale	1639-2005'
Lime and shale	2005-3591'
Lime	3591-3870'
Lime and shale	3870-4630'
Lime	4630-4965'
Lime and chert	4965-4997'
Lime and shale	4997-5500'
Lime	5500-5600'
Lime and shale	5600-5965'
Sand	5965-5986'
Lime and shale	5986-6327'

Total Depth 6327'

I hereby certify the foregoing statements are true and correct to the best of my knowledge and belief.

R.E. McDaniel  
R.E. McDaniel Pet. Engr.

Subscribed and sworn to before me, a Notary Public, this 14 day of May 1953

J. L. Keyler  
Notary Public