


STATE OF KANSAS
STATE CORPORATION COMMISSION

Give All Information Completely
Make Required Affidavit
Mail or Deliver Report to:
Conservation Division
State Corporation Commission
211 No. Broadway
Wichita, Kansas

WELL PLUGGING RECORD

NORTH

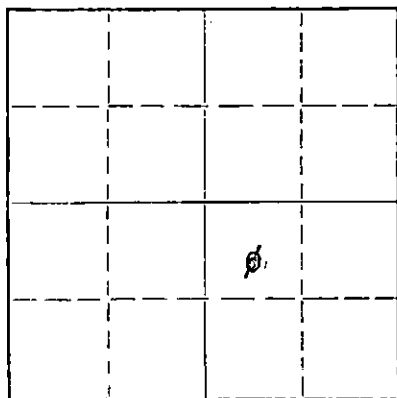

Locate well correctly on above
Section Plat

Seward

County, Sec. 2 Twp. 35 S Rge. (E) 32 (W)Location as "NE/CNW/SW" or footage from lines 1980' from South & East LinesLease Owner Phillips Petroleum CompanyLease Name Nellie B Lease ~~Trappe~~ Well No. 1Office Address Box 241 Guymon, OklahomaCharacter of Well (completed as Oil, Gas or Dry Hole) OilDate well completed October 13, 19 54Application for plugging filed March 26, 19 58Application for plugging approved March 31, 19 58Plugging commenced April 8, 19 58Plugging completed April 11, 19 58Reason for abandonment of well or producing formation Uneconomical to operate, insufficient oil production.If a producing well is abandoned, date of last production March 31, 19 58Was permission obtained from the Conservation Division or its agents before plugging was commenced? YesName of Conservation Agent who supervised plugging of this well Merle A. RivesProducing formation Morrow Sand Depth to top 5983 Bottom 5990 Total Depth of Well 6207 Feet

Show depth and thickness of all water, oil and gas formations.

OIL, GAS OR WATER RECORDS

CASING RECORD

FORMATION	CONTENT	FROM	TO	SIZE	PUT IN	PULLED OUT
Time, cored	No show	4910	4928			
Morrow Sand, cored	Gas & Oil	5978	5990			
Mississippi, cored	No show	5990	6010			
				13-3/8"	639	None
				8-5/8"	2399	901
				5-1/2"	6207	2620

Describe in detail the manner in which the well was plugged, indicating where the mud fluid was placed and the method or methods used in introducing it into the hole. If cement or other plugs were used, state the character of same and depth placed, from _____ feet to _____ feet for each plug set.

Dumped crushed rock and sand in hole to 5100', dumped 9 sacks common cement on top to 5025'. Shot off 5 1/2" casing at 2609'. Pulled up to 2300' and circulated 29 sacks of Gel-Bentonite, 50 viscosity, mud. Pulled 85 joints, 2620', of 5 1/2" casing. Mudded 8-5/8" casing to 380'. Shot off 8-5/8" casing at 900' and pulled 23 joints, 901'. Set bridge at 650', filled with 35 sacks cement to 610'. Mudded with 50 viscosity mud to 115'. Set wood plug at 115'. Filled with rock and sand to 20'. Cemented from 20' to bottom of cellar with 16 sacks cement. Well plugged 5:00 PM April 11, 1958.

RECEIVED

STATE CORPORATION COMMISSION

APR 16 1958

4-16-58

CONSERVATION DIVISION

Wichita, Kansas

(If additional description is necessary, use BACK of this sheet)

Name of Plugging Contractor Gibson Machine and Tool CompanyAddress Box 1111 Borger, TexasSTATE OF Oklahoma, COUNTY OF Texas, ss.F. R. Holtzapple (employee of owner) or (owner or operator) of the above-described

well, being first duly sworn on oath, says: That I have knowledge of the facts, statements, and matters herein contained and the log of the above-described well as filed and that the same are true and correct. So help me God.

(Signature) F. R. HoltzappleBox 241, Guymon, Oklahoma

(Address)

SUBSCRIBED AND SWORN TO before me this 14 th day of April, 19 58My commission expires September 10, 1958

Notary Public.

PLUGGING

FILE SEC 211-35R 320
BOOK PAGE 97 LINE 1