

STATE OF KANSAS
STATE CORPORATION COMMISSION


WELL PLUGGING RECORD

Give All Information Completely
Make Required Affidavit
Mail or Deliver Report to
Conservation Division
State Corporation Comm.
245 North Water
Wichita, KS 67202

Seward County, Sec. 16 Twp. 35S Rge. 33 NE/W
Location as "NE/CNW $\frac{1}{4}$ SW $\frac{1}{4}$ " or footage from lines _____

C NW SW
Lease Owner Funk Petroleum
Lease Name Larco Well No. 1
Office Address P.O. Box 1578, Liberal, Ks.
Character of Well (Completed as Oil, Gas or Dry Hole) _____
Dry Hole

Date Well completed 4-5- 1978
Application for plugging filed _____ 19____
Application for plugging approved 4-5 (verbal) 1978
Plugging commenced 4-5 1978
Plugging completed 4-5 1978
Reason for abandonment of well or producing formation _____
Dry Hole

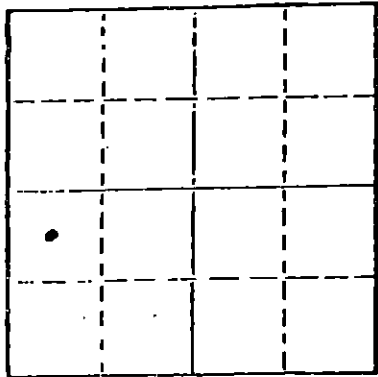

Locate well correctly on above
Section Plat

If a producing well is abandoned, date of last production _____ 19____

Was permission obtained from the Conservation Division or its agents before plugging was commenced? Yes

Name of Conservation Agent who supervised plugging of this well Clarence Thomas Jr.
Producing formation _____ Depth to top _____ Bottom _____ Total Depth of Well 6370
Show depth and thickness of all water, oil and gas formations.

OIL, GAS OR WATER RECORDS				CASING RECORD		
FORMATION	CONTENT	FROM	TO	SIZE	PUT IN	PULLED OUT
				8 5/8	1446'	None

Describe in detail the manner in which the well was plugged, indicating where the mud fluid was placed and the method or methods used in introducing it into the hold. If cement or other plugs were used, state the character of same and depth placed, from _____ feet to _____ feet for each plug set.

pumped cement as follows: 70 sacks @ 3530'
35 sacks @ 1400'
10 sacks from 0-40'
5 sacks in rat. hole

RECEIVED
STATE CORPORATION COMMISSION
APR 11 1978
4-11-78
CONSERVATION DIVISION
Wichita, Kansas

(If additional description is necessary, use BACK of this sheet)

Name of Plugging Contractor Halliburton, Liberal, Kansas

STATE OF Kansas COUNTY OF Seward, ss.
Harold K. Frauli, Agent (employee of owner) or (owner or operator)
of the above-described well, being first duly sworn on oath, says: That I have knowledge of the facts, statements, and matters herein contained and the log of the above-described well as filed and that the same are true and correct. So help me God.

(Signature) Harold K Frauli
P.O. Box 1578, Liberal, Kansas 67901
(Address)

SUBSCRIBED AND SWORN TO before me this 10th day of April, 19 78

Rhenda J. Van Meter
Notary Public.

My commission expires _____



DRILLERS LOG

LARCO NO. 1

CASING RECORD:	OPERATOR: Funk Petroleum, Inc.	DESCRIPTION:
8-5/8" set @ 1446' w/700 sax cement	CONTRACTOR: Sage Drilling Co., Inc.	C NW SW Sec. 16-35S-33W Seward County, Kansas.
TOTAL DEPTH: 6370'	COMMENCED: March 22, 1978	
	COMPLETED: April 5, 1978	

<u>FORMATION</u>	<u>FROM</u>	<u>TO</u>	<u>REMARKS</u>
Surface Soil & Red Bed	0	344	
Red Bed	344	1320	
Red Bed & Shells	1320	1450	
Red Bed	1450	1465	
Red Bed & Shells	1465	1875	
Shells & Shale	1875	2290	
Shale & Lime	2290	2540	
Anhydrite & Dolomite	2540	2712	
Lime & Shale	2712	2967	
Dolomite	2967	3354	
Lime & Shale	3354	3510	
Dolomite	3510	3670	
Lime & Shale	3670	3915	
Shale & Lime	3915	4200	
Lime & Shale	4200	4365	
Shale & Lime	4365	4550	
Lime & Shale	4550	6370	

RECEIVED
SAGE DRILLING CO.
APR 13 1978
CO. SAGE DRILLING CO.
WICHITA, KANSAS

Logged Hole;
Ran DST#1;
Ran DST#2;
Ran DST#3;
D&A

I certify that this is a true and correct copy of the log on the above captioned well to the best of my knowledge.

SAGE DRILLING CO., INC.

By John R. Bartholomew
John R. Bartholomew

Subscribed and sworn to before me this 12th day of April, 1978.

Louise K. Whitted
Louise K. Whitted, Notary Public

My commission expires:
November 26, 1978.

