

STATE OF KANSAS  
STATE CORPORATION COMMISSION


Give All Information Completely  
Make Required Affidavit  
Mail or Deliver Report to:  
Conservation Division  
State Corporation Commission  
211 No. Broadway  
Wichita, Kansas

WELL PLUGGING RECORD

Seward County, Sec. 10 Twp. 35 Rge. (E) 33 (W)

Location as "NE/CNW/SW" or footage from lines. C NE SW  
Lease Owner An-Son Corporation  
Lease Name Howland Well No. 1  
Office Address 3814 North Santa Fe, Oklahoma City, Oklahoma  
Character of Well (completed as Oil, Gas or Dry Hole) Gas  
Date well completed September 8th 19 63  
Application for plugging filed March 28th 19 66  
Application for plugging approved March 30th 19 66  
Plugging commenced April 8th 19 66  
Plugging completed April 12th 19 66  
Reason for abandonment of well or producing formation Non-Commercial

NORTH

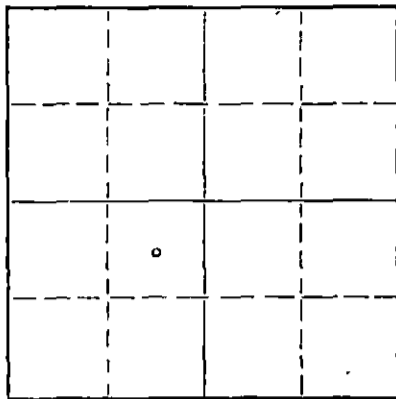

Locate well correctly on above  
Section Plat

If a producing well is abandoned, date of last production December 31, 1965  
Was permission obtained from the Conservation Division or its agents before plugging was commenced? yes

Name of Conservation Agent who supervised plugging of this well Mr. Edgar Eves  
Producing formation Morrow Depth to top 6148 Bottom 6236 Total Depth of Well 6800 Feet  
Show depth and thickness of all water, oil and gas formations.

OIL, GAS OR WATER RECORDS

CASING RECORD

FORMATION	CONTENT	FROM	TO	SIZE	PUT IN	PULLED OUT
Council Grove	Dry	3046	3070	8 5/8"	1533	None
Toronto	Dry	4413	4513	5 1/2"	6604	2580
Lansing	Dry	4550	4580			
Marmaton	Dry	5260	5300			
Morrow	Gas	5830	5880			
Chester	Oil	6165	6280			
St. Genevieve	Dry	6525	6560			
St. Louis	Dry	6624	6700			

Describe in detail the manner in which the well was plugged, indicating where the mud fluid was placed and the method or methods used in introducing it into the hole. If cement or other plugs were used, state the character of same and depth placed, from \_\_\_\_\_ feet to \_\_\_\_\_ feet for each plug set.

- 4-8-66 Spotted unit and raised pole. Dug out cellar. Rigged up Sun oil well cementing Company to pump 25 sacks cement to 6100 ft - 10 hours.
- 4-9-66 Had welder weld on 5 1/2" nipple. Rigged up jacks to pull 5 1/2" casing. Took casing off head and worked casing - 10 hours.
- 4-11-66 Worked 5 1/2" casing, shot at 3927, 3516, 3007, 2828, 2578 and worked and started casing. Pulled 58 joints of 5 1/2" casing.
- 4-12-66 Rigged up Sun Cementing to pump 35 sacks cement from 600 to 700 ft. Pulled 23 joints of 5 1/2" casing. Set Bridge plug at 40 foot and capped well with 15 sacks cement.
- 4-27-66 Cut surface off below plow depth and welded steel plate cap on surface.

RECEIVED  
STATE CORPORATION COMMISSION

APR 29 1966

CONSERVATION DIVISION  
Wichita, Kansas

(If additional description is necessary, use BACK of this sheet)

Name of Plugging Contractor Gayle E. Toland  
Address 1317 S.E. 29th Street, Oklahoma City, Oklahoma

STATE OF Oklahoma, COUNTY OF Oklahoma, ss.  
Raymond Price (employee of owner) or (owner or operator) of the above-described well, being first duly sworn on oath, says: That I have knowledge of the facts, statements, and matters herein contained and the log of the above-described well as filed and that the same are true and correct. So help me God.

(Signature) Raymond Price

(Address)

SUBSCRIBED AND SWORN to before me this 28<sup>th</sup> day of April, 19 66

My commission expires Jan 28, 1969

Virginia J. Gillis  
Notary Public