


STATE OF KANSAS
STATE CORPORATION COMMISSION

WELL PLUGGING RECORD

Give All Information Completely
Make Required Affidavit
Mail or Deliver Report to:
Conservation Division
State Corporation Commission
800 Biting Building
Wichita, Kansas

Seward County. Sec. 6 Twp. 35 Rge. 33 (X) W (W)
Location as "NE/CNW/SW" or footage from lines 1800' S & 1450' E of NW corner
Lease Owner John B. Hawley, Jr. of Sec. 6
Lease Name Liberal Airport Well No. 3
Office Address Box 94, Great Bend, Kansas
Character of Well (completed as Oil, Gas or Dry Hole) Gas
Date well completed May 2 19 51
Application for plugging filed August 13 19 56
Application for plugging approved August 14 19 56
Plugging commenced August 22 19 56
Plugging completed August 31 19 56
Reason for abandonment of well or producing formation Dry

NORTH

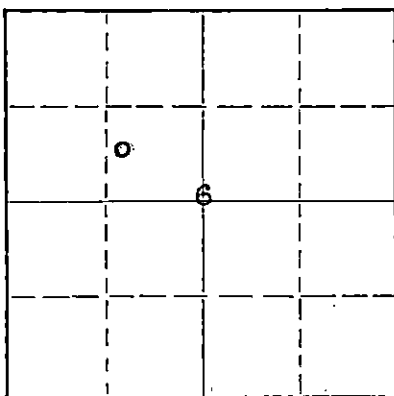

Locate well correctly on above
Section Plat

If a producing well is abandoned, date of last production March 19 53
Was permission obtained from the Conservation Division or its agents before plugging was commenced? Yes

Name of Conservation Agent who supervised plugging of this well M. A. Rives, Box 8, Pratt, Kansas
Producing formation Krider Depth to top 2684 Bottom 2714 Total Depth of Well 2720 Feet
Show depth and thickness of all water, oil and gas formations.

OIL, GAS OR WATER RECORDS

CASING RECORD

FORMATION	CONTENT	FROM	TO	SIZE	PUT IN	PULLED OUT
				10-3/4"	684'	None
				7"	2719'	911'

Describe in detail the manner in which the well was plugged, indicating where the mud fluid was placed and the method or methods used in introducing it into the hole. If cement or other plugs were used, state the character of same and depth placed, from _____ feet to _____ feet for each plug set.

Pump 125 sack cement plug on bottom - fillup to 2100'.
Shot pipe off at 911' - Circulate heavy mud and pull 7" casing.
Bail hole down to 450' - Set rock bridge and dump 25 sacks cement.
Mud hole to 35' - Set rock bridge and 10 sacks of cement.

684' of 10-3/4" surface casing was cemented with 425 sacks - circulated
2719' of 7" casing was cemented with 150 sacks.

FILED
STATE OF KANSAS
1956
9-1-56

(If additional description is necessary, use BACK of this sheet)
Name of Plugging Contractor Northern Pump Company
Address Box 94, Great Bend, Kansas

STATE OF Kansas, COUNTY OF Barton, ss.
Dale R. Overholt (employee of owner) or (owner or operator) of the above-described well, being first duly sworn on oath, says: That I have knowledge of the facts, statements, and matters herein contained and the log of the above-described well as filed and that the same are true and correct. So help me God.

(Signature) Dale R. Overholt
Box 94, Great Bend, Kansas (Address)

SUBSCRIBED AND SWORN TO before me this 31st day of August, 19 56

My commission expires January 28, 1959
Claudine Turner
Claudine Turner Notary Public.

PLUGGING
FILE SEC 6 T 35 R 33W
BOOK PAGE 90 LINE 1

Contractor:
 Baco Drilling Company
 Box 671
 Liberal, Kansas

John B. Hawley, Jr.
 Liberal Airport #3
 1800' S. & 1450' E. of
 NW/corner of
 Sec. 6-T35S-R33W
 Seward County, Kansas

Elevation: Ground 2871.5'

TOTAL DEPTH: 2720'
 Commenced: March 21, 1951
 Completed: May 2, 1951
 Casing: 684' - 10-3/4" 32.75# - cement w/425 sacks
 2719' - 7" 20.00# - cement w/150 sacks

Figures indicate bottom of formation:

0'	to	190'	Surface Clay and Sand.
190'		433'	Sand and Gyp.
433'		665'	Clay and Sand.
665'		822'	Redbed.
822'		1175'	Redbed and Shale.
1175'		1575'	Shale, Redbed and Gyp.
1575'		1632'	Anhydrite and Redbed.
1632'		1835'	Shale and Anhydrite.
1836'		1910'	Anhydrite and Redbed.
1910'		2169'	Shale and Anhydrite.
2169'		2275'	Anhydrite and Redbed.
2275'		2600'	Shale and Anhydrite.
2600'		2632'	Shale, Lime and Anhydrite.
2632'		2716'	Shale and Lime.
2716'		2720'	Lime
		2720'	<u>ROTARY TOTAL DEPTH</u>

RECEIVED
 STATE CORPORATION COMMISSION

APR 17 1955
 CONSERVATION DIVISION
 Topeka, Kansas

PLUGGING
 FILE SEC 6 T 35 R 33W
 BOOK PAGE 90 LINE 1