


Give All Information Completely
Make Required Affidavit
Mail or Deliver Report to:
Conservation Division
State Corporation Commission
211 No. Broadway
Wichita, Kansas

WELL PLUGGING RECORD

NORTH

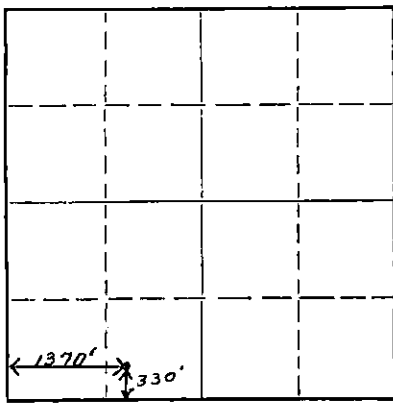

Locate well correctly on above
Section Plat

MEADE County, Sec. 18 Twp. 35S Rge. 29W (E) - (W) -
Location as "NE/CNW%SW%" or footage from lines 330' from S. line, 1370' from W. line
Lease Owner EDWIN L. COX
Lease Name H. G. ADAMS Well No. 1
Office Address P. O. BOX 578 - HEALDTON, OKLAHOMA
Character of Well (completed as Oil, Gas or Dry Hole) DRY HOLE
Date well completed 12 - 29 - 1965
Application for plugging filed 12 - 29 - 1965
Application for plugging approved 19
Plugging commenced 12 - 29 - 1965
Plugging completed 12 - 30 - 1965
Reason for abandonment of well or producing formation NO COMMERCIAL SHOW OF OIL OR GAS
If a producing well is abandoned, date of last production - 19 -
Was permission obtained from the Conservation Division or its agents before plugging was commenced? YES

Name of Conservation Agent who supervised plugging of this well MR. H. E. SCOTT
Producing formation - Depth to top - Bottom - Total Depth of Well 6415 Feet
Show depth and thickness of all water, oil and gas formations.

OIL, GAS OR WATER RECORDS

CASING RECORD

FORMATION	CONTENT	FROM	TO	SIZE	PUT IN	PULLED OUT
MORROW	NIL	5825	5840	CONDUCTOR	37.00'	NONE
"	NIL	5850	5862	8-5/8"	1477.00	NONE

Describe in detail the manner in which the well was plugged, indicating where the mud fluid was placed and the method or methods used in introducing it into the hole. If cement or other plugs were used, state the character of same and depth placed, from _____ feet to _____ feet for each plug set.

PLUGGING PROCEDURE:

- 1. Set 35 sack cement plug with bottom at 700'
- 2. Set 15 sack cement plug with bottom at 45'

Hole filled with drilling mud.

RECEIVED
STATE CORPORATION COMMISSION
JAN 4 1966
CONSERVATION DIVISION
WICHITA, KANSAS

(If additional description is necessary, use BACK of this sheet)

Name of Plugging Contractor NOBLE DRILLING CORPORATION
Address 207 PAN AMERICAN BUILDING - TULSA, OKLAHOMA

STATE OF OKLAHOMA, COUNTY OF CARTER, ss.
J. L. LEE (employee of owner) ~~NOBLE DRILLING CORPORATION~~

well, being first duly sworn on oath, says: That I have knowledge of the facts, statements, and matters herein contained and the log of the above-described well as filed and that the same are true and correct. So help me God.

(Signature) J. L. Lee Div. Supt.
P. O. Box 578 - HEALDTON, OKLAHOMA
(Address)

SUBSCRIBED AND SWORN TO before me this 30th day of DECEMBER, 19 65

My commission expires 10-24-67

W. B. [Signature]
Notary Public.

