

15-119-00174-0000


STATE OF KANSAS
STATE CORPORATION COMMISSION

WELL PLUGGING RECORD

Give All Information Completely
Make Required Affidavit
Mail or Deliver Report to:
Conservation Division
State Corporation Commission
800 Bittling Building
Wichita, Kansas

Meade County, Sec. 16 Twp. 35 Rge. 29 W (W)

Location as "NE/CNW $\frac{1}{4}$ SW $\frac{1}{4}$ " or footage from lines C NW/4 NE/4
Lease Owner Deep Rock Oil Corporation
Lease Name R. E. Adams "B" Well No. 1
Office Address Box 1051, Tulsa, Oklahoma
Character of Well (completed as Oil, Gas or Dry Hole) Dry Hole
Date well completed October 25 19 52
Application for plugging filed October 27 19 52
Application for plugging approved October 28 19 52
Plugging commenced October 25 19 52
Plugging completed October 25 19 52
Reason for abandonment of well or producing formation Dry Hole

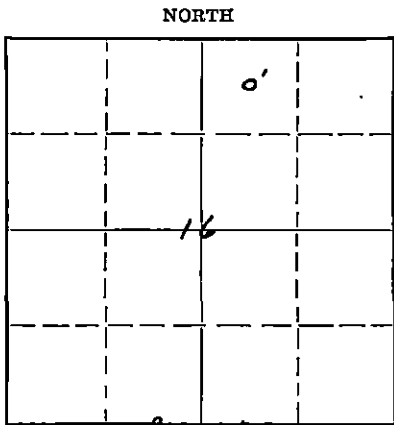

If a producing well is abandoned, date of last production 19
Was permission obtained from the Conservation Division or its agents before plugging was commenced? Yes

Name of Conservation Agent who supervised plugging of this well M. A. Rives
Producing formation Depth to top Bottom Total Depth of Well 6296 Feet
Show depth and thickness of all water, oil and gas formations.

OIL, GAS OR WATER RECORDS

CASING RECORD

Formation	Content	From	To	Size	Put In	Pulled Out
				13-3/8"	426'	None
				9-5/8"	2535'	1125'
				5-1/2"	6137'	2644'

Describe in detail the manner in which the well was plugged, indicating where the mud fluid was placed and the method or methods used in introducing it into the hole. If cement or other plugs were used, state the character of same and depth placed, from feet to feet for each plug set.

Filled hole with heavy mud to 300 feet and dumped one sack of hulls and pushed Halliburton wood plug wood plug to 300 feet. Mixed and pumped in 30 sacks of regular cement from 300 feet to 262 feet. Filled hole from 262 feet with heavy mud up to 25 feet and dumped in one sack of hulls. Pushed Halliburton wood plug to 25 feet. Mixed and pumped in 20 sacks regular cement to top of hole and into cellar and welded plate on top of surface pipe.

(If additional description is necessary, use BACK of this sheet)

Name of Plugging Contractor Norwood Drilling Company
Address 730 Wichita National Bank Building, Wichita Falls, Texas

STATE OF Kansas, COUNTY OF Reno, SS.
Jack Smith (employee of owner) or (owner or operator) of the above-described well, being first duly sworn on oath, says: That I have knowledge of the facts, statements, and matters herein contained and the log of the above-described well as filed and that the same are true and correct. So help me God.

(Signature) *Jack Smith*

Box 1146, Hutchinson, Kansas
(Address)

SUBSCRIBED AND SWORN TO before me this 28th day of November, 1952

Alvin L. Walker
Notary Public.

My commission expires September 28, 1955

23-8390-s 6-51-20M

PLUGGING
FILE SEC 16 T 35 R 227
BOOK PAGE 55 LINE 5

NOV 20 1952
11-29-52
CONSERVATION DIVISION
Wichita, Kansas

DRILLER'S LOG

Deep Rock Oil Company's #1 R. E. Adams "B" located C NW/4, NE/4 of Section 16-35S-29W, Meade County, Kansas

<u>FORMATIONS</u>	<u>TOP</u>	<u>BOTTOM</u>
Surface	0	314
Red bed & Shells	314	1280
Shells, Anhy & Salt	1280	1715
Anhy-Salt-Blue Shale	1715	1902
Lime, Anhy & Salt	1902	2309
Anhy & Salt	2309	2355
Anhy & Shale	2355	2409
Lime & Anhy	2409	2527
Lime	2527	2821
Lime & Stks Shale	2821	2882
Lime	2882	3106
Lime & Shale	3106	3360
Lime	3360	3426
Lime & Shale	3426	3644
Lime	3644	3704
Lime & Shale	3704	3771
Shale	3771	4038
Shale & Lime Stks	4038	4235
Shale & Lime	4235	4444
Lime	4444	4471
Lime & Shale	4471	4514
Lime	4514	4542
Lime & Shale	4542	4563
Lime	4563	4802
Lime & Stks Shale	4802	4831
Lime	4831	5227
Lime & Shale	5227	5311
Lime	5311	5344
Lime Cherty	5344	5365
Lime	5365	5391
Lime & Shale	5391	5417
Lime & Chert	5417	5423
Lime	5423	5442
Lime & Shale Stks	5442	5476
Lime	5476	5494
Lime & Shale	5494	5553
Lime	5553	5572
Lime & Shale	5572	5850
Coring	5852	5928
Reaming	5852	5924
Coring	5928	5975
Reaming	5928	5962
Reaming	5862	5975
Shale & Lime	5975	6042
Lime	6042	6045
Lime & Shale	6045	6284
Lime	6284	6288
DST #6-Circulate for Electric Log & Run electric log	6288	6296

PLUGGING
 FILE SEC 16 T 35 R 29
 BOOK PAGE 55 LINES 5

RECEIVED
 NOV 26 1952
 Hutchinson, Kansas

- Total Depth

I, D. C. Norwood, Partner Norwood Drilling Company, being first duly sworn on oath state that I have knowledge of the facts and matter herein set forth and that the same are true and correct.

D. C. Norwood
 D. C. Norwood

Subscribed and sworn to before me this 24th day of November, 1952.

RECEIVED
 STATE CORPORATION COMMISSION
 Notary Public, Wichita County, Texas
 NOV 29 1952
 CONSERVATION DIVISION
 Wichita, Kansas