


STATE OF KANSAS  
STATE CORPORATION COMMISSION

Give All Information Completely  
Make Required Affidavit  
Mail or Deliver Report to:  
Conservation Division  
State Corporation Commission  
211 No. Broadway  
Wichita, Kansas

WELL PLUGGING RECORD

T - 35S NORTH R - 29W

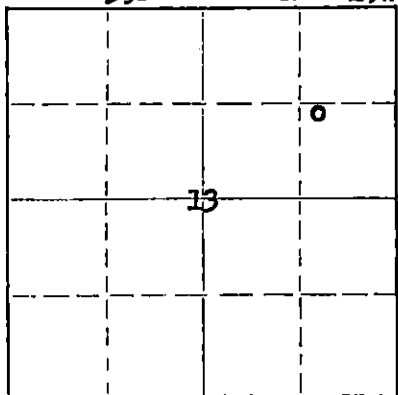

Locate well correctly on above  
Section Plat

Meade County. Sec. 13 Twp. 35S Rge. 29 (E) W (W)  
Location as "NE/CNW%SW%" or footage from lines NW SE NE  
Lease Owner Frank J. Black  
Lease Name Raymond Adams Well No. 1  
Office Address McPherson, Kansas  
Character of Well (completed as Oil, Gas or Dry Hole) Oil  
Date well completed 11-5-59 19  
Application for plugging filed 3-15-62 19  
Application for plugging approved 3-16-62 19  
Plugging commenced 4-16-62 19  
Plugging completed 4-19-62 19  
Reason for abandonment of well or producing formation Depleted.

If a producing well is abandoned, date of last production 19  
Was permission obtained from the Conservation Division or its agents before plugging was commenced? yes

Name of Conservation Agent who supervised plugging of this well Victor Simoncie  
Producing formation \_\_\_\_\_ Depth to top \_\_\_\_\_ Bottom \_\_\_\_\_ Total Depth of Well 6088 Feet  
Show depth and thickness of all water, oil and gas formations.

OIL, GAS OR WATER RECORDS

CASING RECORD

FORMATION	CONTENT	FROM	TO	SIZE	PUT IN	PULLED OUT
				13-3/8"	189'	None
				5-1/2"	6018'	3834'
				8-5/8"	2334'	None

Describe in detail the manner in which the well was plugged, indicating where the mud fluid was placed and the method or methods used in introducing it into the hole. If cement or other plugs were used, state the character of same and depth placed, from \_\_\_\_\_ feet to \_\_\_\_\_ feet for each plug set.

Checked hole, sanded from 6088' to 6000' and dumped 5 sacks of cement @ 6000' with dump bailer. Pulled 5 1/2" casing. Set plug @ 1200' and ran 20 sacks of cement. Mudded from 1140' to 40', set 10' rock bridge and ran 10 sacks of cement to base of cellar.

PLUGGING COMPLETE

APR 24 1964  
STATE CORPORATION COMMISSION

APR 30 1964  
CONSERVATION DIVISION

(If additional description is necessary, use BACK of this sheet)  
Name of Plugging Contractor Knight Casing Pulling Company  
Address Chase, Kansas

STATE OF Kansas, COUNTY OF Rice, ss.  
Noel J. Knight (employee of owner) or ~~owner or operator~~ of the above-described well, being first duly sworn on oath, says: That I have knowledge of the facts, statements, and matters herein contained and the log of the above-described well as filed and that the same are true and correct. So help me God.

(Signature) Noel J. Knight  
Chase, Kansas  
(Address)

SUBSCRIBED AND SWORN to before me this 24th day of April, 1964

My commission expires May 20, 1964

Milton J. Volin  
Notary Public.



WELL LOG BUREAU—KANSAS GEOLOGICAL SOCIETY

502 East Murdock,

Wichita, Kansas

COPY

15-119-10227-0000

Company-CARTER OIL CO.

Farm- R. Adams

No. 1

SEC. 13 S. 35

R. 29W

NW SE NE

Total Depth. 6088'

Comm. 10-16-59

Comp. 11-5-59


Shot or Treated.

Contractor. Garvey Drlg. Co.

Issued. 1-2-60

County Meade

KANSAS

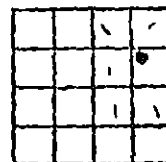

Elevation. 2299 DF

Production. 9,000,000 CFPD

Cal. open flow

Figures indicate Bottom of Formations.

soil & sand	40
sand & red rock	191
red bed & gyp.	1120
gyp. & sand	1465
red bed	1620
gyp. & red bed	2210
limey gyp. & red bed	2517
Anhydrite	2341
sand	2493
shale & lime	2643
sand & shaley lime	2805
lime	2885
lime & shale	3004
shale, lime & chalk	3155
lime & shale-chalky	3515
shale & lime	4505
lime & shale	4944
lime	5010
lime & shale	5800
lime & sandy shale	5821
sand	5841
lime & shale	6088
Total Depth	

TOPS:	
Wreford	2837
Council Grove	2921
U. Marmaton	5250
L. Marmaton	5350
13 Finger Lime	5633
Morrow Shale	5741
Morrow Sand	5821
Chester	5882

RECEIVED  
STATE CORPORATION COMMISSION

APR 30 1962

CONSERVATION DIVISION  
Wichita, Kansas