

STATE OF KANSAS
STATE CORPORATION COMMISSION


Form CP-4

WELL PLUGGING RECORD

Give All Information Completely
Make Required Affidavit
Mail or Deliver Report to:
Conservation Division
State Corporation Commission
P. O. Box 17027
Wichita, Kansas 67217
NORTH

Meade County, Sec. 10 Twp. 35S Rge. 29W (W)

Location as "NE/CNW&SW" or footage from lines. C-NW-SE
Lease Owner R. Clay Underwood
Lease Name Jessie S. Adams Well No. F-11
Office Address 420 Oil & Gas Bldg., Wichita Falls, Texas 76301
Character of Well (completed as Oil, Gas or Dry Hole) Dry Hole
Date well completed May 4 19 77
Application for plugging filed May 4 19 77
Application for plugging approved May 4 19 77
Plugging commenced May 4 19 77
Plugging completed May 4 19 77
Reason for abandonment of well or producing formation Dry Hole

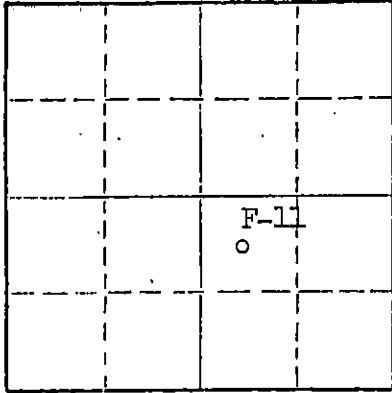

Locate well correctly on above
Section Plat

If a producing well is abandoned, date of last production No production 19
Was permission obtained from the Conservation Division or its agents before plugging was commenced? yes

Name of Conservation Agent who supervised plugging of this well Frank Broadfoot
Producing formation none Depth to top Bottom Total Depth of Well 5960 Feet
Show depth and thickness of all water, oil and gas formations.

OIL, GAS OR WATER RECORDS

CASING RECORD

FORMATION	CONTENT	FROM	TO	SIZE	PUT IN	PULLED OUT
				8 5/8"	1549	none

RECEIVED
STATE CORPORATION COMMISSION
MAY 27 1977
CONSERVATION DIVISION
WICHITA, KANSAS

Describe in detail the manner in which the well was plugged, indicating where the mud fluid was placed and the method or methods used in introducing it into the hole. If cement or other plugs were used, state the character of same and depth placed, from feet to feet for each plug set.

Cemented w/600 sx Lite Weight, 2% cc. and 150 sx. Class H, 3% cc.
75 sacks at 4500'
50 sacks at 1600'
25 sacks at 90'

(If additional description is necessary, use BACK of this sheet)
Name of Plugging Contractor Service Drilling Company
Address 1800 Fourth National Bldg., Tulsa, Oklahoma 74119

STATE OF TEXAS, COUNTY OF WICHITA ss.
R. CLAY UNDERWOOD

(owner or operator) of the above-described well, being first duly sworn on oath, says: That I have knowledge of the facts, contents and matters herein contained and the log of the above-described well as filed and that the same are true and correct. So help me God.

(Signature) R. CLAY UNDERWOOD
420 Oil & Gas Bldg., Wichita Falls, Tex 76301
(Address)

SUBSCRIBED AND SWORN to before me this 24 day of May, 19 77

My commission expires June 1, 1977

Betty Wolford
In and For Wichita Co., Texas Notary Public.

R. CLAY UNDERWOOD

Jessie S. Adams Well No. 11 F
Meade County, Kansas

COMMENCED OPERATIONS: 4/14/77
COMPLETED OPERATIONS: 5/4/77

DRILLERS LOG

4/14/77	0 - 976	Surface.
4/15/77	976 - 1573	Red Bed, Anhydrite.
4/16/77	1573 - 1740	Shale, Anhydrite.
4/17/77	1740 - 2560	Shale, Anhydrite.
4/18/77	2560 - 3167	Shale, Lime, Anhydrite.
4/19/77	3167 - 3700	Council Grove, Lime, Shale.
4/20/77	3700 - 4193	Council Grove, Lime, Shale.
4/21/77	4193 - 4375	Lime, Shale. Toronto.
4/22/77	4375 - 4430	Toronto, Lime, Shale.
4/23/77	4430 - 4460	Lansing.
4/24/77	4460 - 4556	Lansing.
4/25/77	4556 - 4600	Lansing.
4/26/77	4600 - 4964	Lansing, Lime, Shale.
4/27/77	4964 - 5220	Lansing, Kans. City.
4/28/77	5220 - 5234	Marmaton.
4/29/77	5234 - 5464	Marmaton, Lime, Shale.
4/30/77	5464 - 5712	Marmaton, Lime, Shale.
5/1/77	5712 - 5819	Marmaton, Morrow.
5/2/77	5819 - 5950	Morrow, Lime, Shale.
5/3/77	5950 - 5960	Chester.

CASING RECORD

4/16/77 Ran 19 Jts. of 8-5/8" K-55 24# casing. Set at 1549'.
cemented with 600 sacks Lite Weight, 2% c.c. and
150 sacks Class H, 3% c.c.

5/4/77 Plugged well. 75 sacks at 4500'.
50 sacks at 1600'.
25 sacks at 90'.

SERVICE DRILLING CO.

APPROVED: Paul Moss

Paul Moss, Secretary

Pauline C. Snow
Notary Public

My commission expires Oct 2, 1977

RECEIVED
STATE CORPORATION COMMISSION

MAY 27 1977

CONSERVATION DIVISION
Wichita, Kansas