


STATE OF KANSAS
STATE CORPORATION COMMISSION

WELL PLUGGING RECORD

Give All Information Completely
Make Required Affidavit
Mail or Deliver Report to:
Conservation Division
State Corporation Commission
211 No. Broadway
Wichita, Kansas

Made: _____ County. Sec. 9 Twp. 35-S Rge. 29 (E) W (W)
Location as "NE/CNW&SW&" or footage from lines SW NW NE
Lease Owner Sehermerhorh Oil Corp
Lease Name Adams Well No. I
Office Address Box 287 Tulsa, Oklahoma
Character of Well (completed as Oil, Gas or Dry Hole) Dry Hole
Date well completed 2/26 19 64
Application for plugging filed 2/26 19 64
Application for plugging approved yes 19 64
Plugging commenced 2/26 19 64
Plugging completed 2/26 19 64
Reason for abandonment of well or producing formation Dry Hole

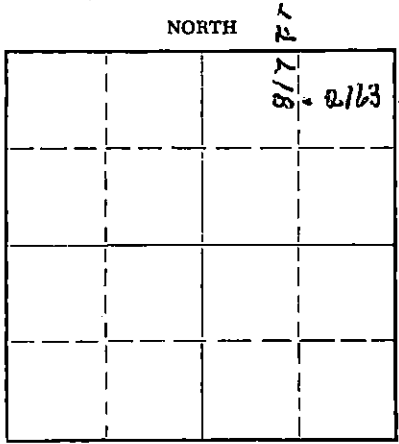

Locate well correctly on above Section Plat

If a producing well is abandoned, date of last production _____ 19 ____
Was permission obtained from the Conservation Division or its agents before plugging was commenced? Yes

Name of Conservation Agent who supervised plugging of this well Hugh Scott
Producing formation _____ Depth to top _____ Bottom 3185 Total Depth of Well 3185 Feet
Show depth and thickness of all water, oil and gas formations.

OIL, GAS OR WATER RECORDS

CASING RECORD

FORMATION	CONTENT	FROM	TO	SIZE	PUT IN	PULLED OUT
				8 5/8	696 ft	

Describe in detail the manner in which the well was plugged, indicating where the mud fluid was placed and the method or methods used in introducing it into the hole. If cement or other plugs were used, state the character of same and depth placed, from _____ feet to _____ feet for each plug set.

Plug at 696 ft. Bottom of surface pipe cemented through drill pipe with 35 sacks.
Plug set at 40 ft. cemented with 15 sacks cement to within 3 ft. of surface.
Cemented by Haliburton Cementing Co.

Completed 9:45 AM

RECEIVED
STATE CORPORATION COMMISSION
MAR 2 1964
CONSERVATION DIVISION
Wichita, Kansas

(If additional description is necessary, use BACK of this sheet)
Name of Plugging Contractor Ryan Drilling Co.
Address Liberal, Kansas

STATE OF Kansas, COUNTY OF meade, ss. _____ (employee of owner) or (owner or operator) of the above-described well, being first duly sworn on oath, says: That I have knowledge of the facts, statements, and matters herein contained and the log of the above-described well as filed and that the same are true and correct. So help me God.

(Signature) E E Savage
320 N - Howard Pratt Kansas
(Address)

SUBSCRIBED AND SWORN TO before me this 29 day of Feb, 19 64

My commission expires June 24, 1965

Charles K. Resh
Notary Public.