


STATE OF KANSAS
-STATE CORPORATION COMMISSION

WELL PLUGGING RECORD

Give All Information Completely
Make Required Affidavit
Mail or Deliver Report to:
Conservation Division
State Corporation Commission
800 Bitting Building
Wichita, Kansas

Meade County. Sec. 6 Twp 35 S Rge. 29 W (E) (W)
Location as "NE/CNW/SW" or footage from lines Center NE/4 NW/4
Lease Owner Columbian Fuel Corporation
Lease Name A. G. Adams Well No. 1-G
Office Address Box 994, Liberal, Kansas
Character of Well (completed as Oil, Gas or Dry Hole) Dry Hole
Date well completed November 3, 1951 19
Application for plugging filed 11/6/51 19
Application for plugging approved 11/7/51 19
Plugging commenced November 3, 1951 19
Plugging completed November 30, 1951 19
Reason for abandonment of well or producing formation Dry Hole

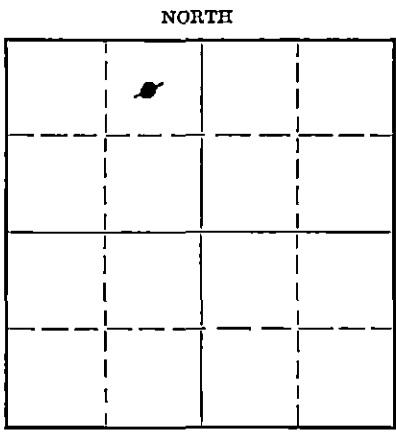

Locate well correctly on above Section Plot

If a producing well is abandoned, date of last production 19
Was permission obtained from the Conservation Division or its agents before plugging was commenced? Yes
Name of Conservation Agent who supervised plugging of this well R. J. Phillippe
Producing formation X Depth to top X Bottom X Total Depth of Well 6250' Feet
Show depth and thickness of all water, oil and gas formations.

OIL, GAS OR WATER RECORDS CASING RECORD

Formation	Content	From	To	Size	Put In	Pulled Out
Lime	Water	5247'	5251	13 3/8"	626	None
				9 5/8"	2561	None
				5 1/2"	5314	4410

Describe in detail the manner in which the well was plugged, indicating where the mud fluid was placed and the method or methods used in introducing it into the hole. If cement or other plugs were used, state the character of same and depth placed, from feet to feet for each plug set.

Hole filled from T.D. 6250' to 5314' (5 1/2" casing point) with mud.
Pumped 25 sacks cement into perforations 5247'-51' Left top ft of cement @ 5107' in 5 1/2" casing.

- 5107' to 815' Mud
- 815' - 805' Cement Plug
- 805' - 250' Heavy Mud
- 250' - 240' Rock Bridge
- 240' - 178' Cement Plug, 25 sks. cement.
- 178' - 35' Heavy Mud
- 35' - 30' Rock Bridge
- 30' - Top of casing - 15 sks. cement, plug.
- Top of casing cut off 4 feet below ground level.

STATE OF
(If additional description is necessary, use BACK of this sheet) 12-11-51

Correspondence regarding this well should be addressed to Columbian Fuel Corporation
Address Box 994, Liberal, Kansas

STATE OF Kansas, COUNTY OF Seward, ss.
Robert Grady (employee of owner) or (owner or operator) of the above-described well,
being first duly sworn on oath, says: That I have knowledge of the facts, statements, and matters herein contained and the log of the above-described well as filed and that the same are true and correct. So help me God.

(Signature) Robert Grady
Liberal, Kansas
(Address)

SUBSCRIBED AND SWORN TO before me this 9th day of December 19 51

Robert B. Hillman
Notary Public.

My commission expires October 26, 1955

