


STATE OF KANSAS
STATE CORPORATION COMMISSION
Give All Information Completely
Make Required Affidavit
Mail or Deliver Report to:
Conservation Division
State Corporation Commission
211 No. Broadway
Wichita, Kansas

10
WELL PLUGGING RECORD

Meade County. Sec. 5 Twp. 35S Rge. (E) 29 (W)
Location as "NE/CNW/SW" or footage from lines 330' from north & 2310' from east.
Lease Owner Phillips Petroleum Company
Lease Name Adams J Well No. 1
Office Address Box 241, Guymon, Oklahoma
Character of Well (completed as Oil, Gas or Dry Hole) Oil
Date well completed September 8, 1960 19
Application for plugging filed October 18, 1961 19
Application for plugging approved October 23, 1961 19
Plugging commenced October 24, 1961 19
Plugging completed October 25, 1961 19
Reason for abandonment of well or producing formation Uneconomical to operate

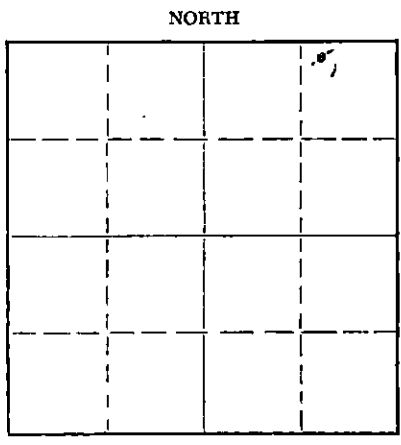

Locate well correctly on above Section Plat

If a producing well is abandoned, date of last production September 20, 1961
Was permission obtained from the Conservation Division or its agents before plugging was commenced? Yes

Name of Conservation Agent who supervised plugging of this well Bill Lackamp
Producing formation Chester Depth to top 5930 Bottom 6202 Total Depth of Well 6231 Feet
Show depth and thickness of all water, oil and gas formations.

OIL, GAS OR WATER RECORDS				CASING RECORD		
FORMATION	CONTENT	FROM	TO	SIZE	PUT IN	PULLED OUT
<u>Chester</u>	<u>Oil</u>	<u>5930</u>	<u>6202</u>	<u>8-5/8"</u> <u>2-7/8"</u>	<u>2082'</u> <u>6230'</u>	<u>None</u> <u>2707'</u>

Describe in detail the manner in which the well was plugged, indicating where the mud fluid was placed and the method or methods used in introducing it into the hole. If cement or other plugs were used, state the character of same and depth placed, from _____ feet to _____ feet for each plug set.

Cemented perforations 5949-6032' with 50 sacks cement, top of cement plug 5500'.
Cut off 2-7/8" casing at 2707', pulled up to 653' and filled hole with 55 barrels drilling mud.
Spotted 45 sacks cement 653' to 549'.
Placed 15 sacks cement in top of surface casing and welded steel plate on top.

10-27-61
10-27-61

(If additional description is necessary, use BACK of this sheet)
Name of Plugging Contractor Phillips Petroleum Company
Address Box 241, Guymon, Oklahoma

STATE OF Oklahoma, COUNTY OF Texas, ss.
A. D. Pickett (employee of owner) or owner of the above-described well, being first duly sworn on oath, says: That I have knowledge of the facts, statements, and matters herein contained and the log of the above-described well as filed and that the same are true and correct. So help me God.

(Signature) A. D. Pickett
Box 241, Guymon, Oklahoma
(Address)

SUBSCRIBED AND SWORN TO before me this 26th day of October, 19 61

My commission expires 7-15-64
G. S. Stevens Notary Public.

