


15-119-20276-0000

STATE OF KANSAS
STATE CORPORATION COMMISSION

WELL PLUGGING RECORD

Give All Information Completely
Make Required Affidavit
Mail or Deliver Report to
Conservation Division
State Corporation Comm.
245 North Water
Wichita, KS 67202

Meade County, Sec. 2 Twp. 35S Rge. 29W E/W
Location as "NE/CNW/SW" or footage from lines
1250 from N. line & 1250 from W. line
Lease Owner Mesa Petroleum Co.
Lease Name Adams Well No. 4-2
Office Address Box 2009 500 Vaughn Bldg. Amarillo, Tx. 79105
Character of Well (Completed as Oil, Gas or Dry Hole)

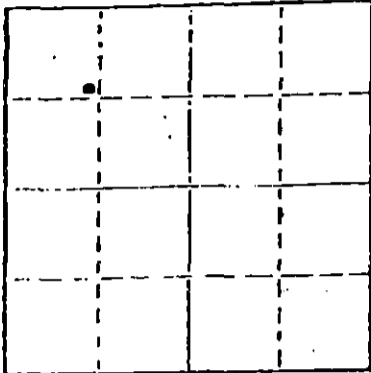

Locate well correctly on above
Section Plot

Date Well completed 19
Application for plugging filed 19
Application for plugging approved 19
Plugging commenced 7-13 1979
Plugging completed 7-15 1979
Reason for abandonment of well or producing formation

If a producing well is abandoned, date of last production 19

Was permission obtained from the Conservation Division or its agents before plugging was commenced? Yes

Name of Conservation Agent who supervised plugging of this well Clarence Thomas
Producing formation Depth to top Bottom Total Depth of Well 6311
Show depth and thickness of all water, oil and gas formations.

OIL, GAS OR WATER RECORDS

CASING RECORD

FORMATION	CONTENT	FROM	TO	SIZE	PUT IN	PULLED OUT
				8 5/8	1509	none
				4 1/2	6349	3217

Describe in detail the manner in which the well was plugged, indicating where the mud fluid was placed and the method or methods used in introducing it into the hold. If cement or other plugs were used, state the character of same and depth placed, from feet to feet for each plug set.

Pump 20 sks. of cement & 1 sk. of hulls @ 5700 to 5916

Pump 35 sks. of cement @ 1560 to 1460

Put 10 sks. of cement @ 40 to 0

RECEIVED
STATE CORPORATION COMMISSION

Aug - 8-3-79

(If additional description is necessary, use BACK of this sheet)

Name of Plugging Contractor Sargent's Casing Pulling Ser. Box 506 Liberal, Kansas 67901 Ks. No. 511

WICHITA DIVISION

STATE OF Texas COUNTY OF Potter, ss.
C. Brad Crouch (employee of owner) or (owner or operator)
of the above-described well, being first duly sworn on oath, says: That I have knowledge of the facts, statements, and matters herein contained and the log of the above-described well as filed and that the same are true and correct. So help me God.

(Signature) C. Brad Crouch
Box 2009, Amarillo, Texas 79189
(Address)

SUBSCRIBED AND SWORN TO before me this 31st day of July, 1979

William Main
William Main Notary Public.

My commission expires 12-31-80