

15-119-00118-0000


*RB*

# WELL PLUGGING RECORD

STATE OF KANSAS  
 STATE CORPORATION COMMISSION  
 Give All Information Completely  
 Make Required Affidavit  
 Mail or Deliver Report to:  
 Conservation Division  
 State Corporation Commission  
 212 North Market, Insurance Bldg.  
 Wichita, Kansas

Meade County. Sec. 2 Twp. 35 Rge. (E) 29 (W)

Location as "NE/CNW/SW" or footage from lines C SE/4  
 Lease Owner Humble Oil & Refining Co., Carter Division  
 Lease Name R. S. Adams Well No. 1  
 Office Address Box 786, Great Bend, Kansas  
 Character of Well (completed as Oil, Gas or Dry Hole) Dry Hole  
 Date well completed 2-3 1960  
 Application for plugging filed 2-19 1960  
 Application for plugging approved 2-23 1960  
 Plugging commenced 4-20 1960  
 Plugging completed 4-23 1960  
 Reason for abandonment of well or producing formation Dry Hole

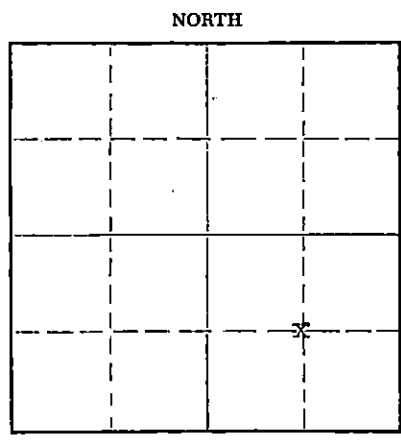

Locate well correctly on above Section Plat

If a producing well is abandoned, date of last production 19  
 Was permission obtained from the Conservation Division or its agents before plugging was commenced? Yes

Name of Conservation Agent who supervised plugging of this well Mr. Bill Lackamp  
 Producing formation \_\_\_\_\_ Depth to top \_\_\_\_\_ Bottom \_\_\_\_\_ Total Depth of Well 6260 Feet  
 Show depth and thickness of all water, oil and gas formations. PBTD 6133'

### OIL, GAS OR WATER RECORDS

### CASING RECORD

FORMATION	CONTENT	FROM	TO	SIZE	PUT IN	PULLED OUT
				8-5/8"	2337'	None
				2-7/8"	6193'	5051'

Describe in detail the manner in which the well was plugged, indicating where the mud fluid was placed and the method or methods used in introducing it into the hole. If cement or other plugs were used, state the character of same and depth placed, from \_\_\_\_\_ feet to \_\_\_\_\_ feet for each plug set.

Halliburton squeeze perforations with 25 sacks of cement. Pulled 2-7/8" casing, cleared hole and mudded the hole to 550', set rock bridge to 540' and dumped 20 sacks of cement. Mudded the hole to 40', set rock bridge to 30' and ran 10 sacks of cement to base of cellar. Plugging completed.

RECEIVED  
 STATE CORPORATION COMMISSION

APR 27 1960

CONSERVATION DIVISION  
 Wichita, Kansas

(If additional description is necessary, use BACK of this sheet)  
 Name of Plugging Contractor Knight Casing Pulling Co.  
 Address Chase, Kansas

STATE OF KANSAS, COUNTY OF BARTON, ss.  
I, Thomas R. Smith (employee of owner) or (~~owner or operator~~) of the above-described well, being first duly sworn on oath, says: That I have knowledge of the facts, statements, and matters herein contained and the log of the above-described well as filed and that the same are true and correct. So help me God.

(Signature) *Thomas R. Smith*  
Box 786, Great Bend, Kansas  
 (Address)

SUBSCRIBED AND SWORN TO before me this 26th day of April, 19 60

My commission expires 8-19-61

*Wm. H. Knisley*  
 Wm. H. KNISLEY Notary Public.



# WELL LOG

COMPANY **HUMBLE OIL & REFINING COMPANY,  
CARTER DIVISION**  
FARM **R. E. ADAMS** NO. **1**

SEC. **2** T. **35S** R. **29W**  
LOC. **C-SE/4**


TOTAL DEPTH **6260'**

COUNTY **MEADE CO., KANSAS**

COMM. **December 24, 1959** COMP. **January 16, 1960**

CONTRACTOR **GARVEY DRILLING COMPANY**

CASING **8 5/8" @ 2019' w/650 sax.  
2 7/8" @ 6165' w/250 sax.**

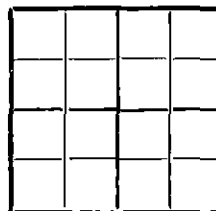

ELEVATION

PRODUCTION

FIGURES INDICATE BOTTOM OF FORMATIONS

40	Surface soil
400	Shale & sand
1262	Red bed
1725	Red bed & gyp
2012	Red bed & lime
2140	Red bed & gyp
2250	Shale & anhydrite
2485	Anhydrite & shale
3135	Lime & shale
3375	Chalky lime & shale
3703	Lime & shale
3797	Shale & lime
4070	Shale
4510	Shale & lime
4805	Lime & shale
4892	Lime
4966	Lime & shale
5028	Lime
5190	Lime & shale
5580	Lime
5985	Lime & shale
5990	Shale w/lime streaks
6251	Lime & shale
6260	Lime
6260	To D.

STATE OF KANSAS  
STATE CONSERVATION COMMISSION  
FEB 25 1960  
CONSERVATION DIVISION  
Wichita, Kansas

State of KANSAS  
County of BARTON } ss:

I, VERNE A. MORRIS of GARVEY DRILLING COMPANY

upon oath state that the above and foregoing is a true and correct copy of the log of the #1 R. E. ADAMS well.

Verne A. Morris

Subscribed and sworn to before me this 4th day of February 19 60

My Commission Expires: April 14, 1963

Arthur J. Mule  
NOTARY PUBLIC