


STATE OF KANSAS
STATE CORPORATION COMMISSION

Form CP-1

Give All Information Completely
Make Necessary Notes of
Material Details Pertaining to
Conservation Division
State Corporation Commission

WELL PLUGGING RECORD

P. O. Box 17027
Wichita, Kansas 67217

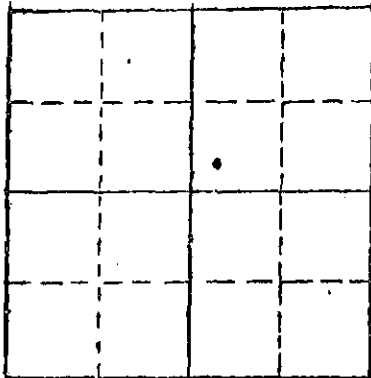

Locate well correctly on above
Section Plat

Meade County, Sec. 1 Twp. 35S Rge. 29 (E) (W)
Location as "NE/SW" or footage from lines 1980' ENL, 1980' EEL
Lease Owner EXXON CORPORATION
Lease Name Adams RANCH Well No. 1
Office Address Box 1600 Midland, TX. 79702
Character of Well (completed as Oil, Gas or Dry Hole) GAS
Date well completed July 11 1955
Application for plugging filed Aug. 19 1977
Application for plugging approved 8-18 1977
Plugging commenced 8-18 1977
Plugging completed 9-13 1977
Reason for abandonment of well or producing formation Well is depleted, loaded w/ water. Will not produce after swabbing.
If a producing well is abandoned, date of last production MAY 1977
Was permission obtained from the Conservation Division or its agents before plugging was commenced? Yes

Name of Conservation Agent who supervised plugging of this well Clarence Thomas
Producing formation Chester Depth to top 3580 Bottom 3610 Total Depth of Well 6175 Feet
Show depth and thickness of all water, oil and gas formations.

OIL, GAS OR WATER RECORDS

CASING RECORD

FORMATION	CONTENT	FROM	TO	SIZE	PUT IN	PULLED OUT
<u>Chester</u>	<u>Gas/Water</u>	<u>3580</u>	<u>3610</u>	<u>13"</u>	<u>531</u>	<u>0</u>
<u>Hodges</u>	<u>Gas</u>	<u>5217</u>	<u>5241</u>	<u>8 5/8"</u>	<u>2457</u>	<u>625</u>
<u>Marmaton</u>	<u>Gas/Water</u>	<u>5459</u>	<u>5504</u>	<u>5 1/2"</u>	<u>6197</u>	<u>2922</u>
<u>Morrow</u>	<u>Gas</u>	<u>5994</u>	<u>6175</u>			

Describe in detail the manner in which the well was plugged, indicating where the mud fluid was placed and the method or methods used in introducing it into the hole. If cement or other plugs were used, state the character of same and depth placed, from _____ feet to _____ feet for each plug set.

Circulated hole w/ 9.5 # mud.
Spotted Plug #1 from 5916' to 6076' w/ 20 Sx. Cement.
Pulled + laid down Tbg.
Spotted Plug #2 from 5800' to 6050' w/ 20 Sx. Cement.
Shot 5 1/2" Csg. worked free + pulled to 2900.
Spotted Plug #3 from 2300' to 2400' w/ 35 Sx. Cement.
Shot 8 5/8" Csg. @ 620' + 700' - Pulled to 546.
Spotted Plug #4 from 446' to 546' w/ 60 Sx. Cement.
Loaded hole w/ mud.
Spotted Plug #5 from 5' to 25' w/ 20 Sx. Cement.
Welded plate on 13 3/8" Surface Casing.

RECEIVED
STATE CORPORATION COMMISSION

SEP 29 1977

CONSERVATION DIVISION
Wichita, Kansas

Name of Plugging Contractor Sargent Casing Pullers (If additional description is necessary, use BACK of this sheet)
Address P.O. Box 506 Liberal, Kansas 67901

STATE OF Texas COUNTY OF Midland ss.

A. L. Tipton (employee of owner) or (owner or operator) of the above-described well, being first duly sworn on oath, says: That I have knowledge of the facts, statements, and matters herein contained and the log of the above-described well as filed and that the same are true and correct. So help me God.

(Signature)

A. L. Tipton
Box 1600 Midland, TX. 79702 (Address)

Subscribed and Sworn to before me this 27 day of September 1977

My commission expires

10-31-78

June Hall
Notary Public.