


15-119-10349-0000

STATE OF KANSAS  
STATE CORPORATION COMMISSION

WELL PLUGGING RECORD

Give All Information Completely  
Notice Required Affidavit  
Mail or Deliver Report to:  
Conservation Division  
State Corporation Commission  
800 Bittling Building  
Wichita, Kansas

Meade County, Sec. 2 Twp. 35 Rge. 30 (E) W (W)  
Location as "NE/CNW/SW" or footage from lines. C SW/4  
Lease Owner United Producing Company, Inc.  
Lease Name A.W. Adams Well No. 1  
Office Address Drawer 30, Liberal, Kansas  
Character of Well (completed as Oil, Gas or Dry Hole) Dryhole  
Date well completed September 14, 19 58  
Application for plugging filed May 12, 19 59  
Application for plugging approved May 13, 19 59  
Plugging commenced June 13, 19 59  
Plugging completed June 22, 19 59  
Reason for abandonment of well or producing formation Dryhole

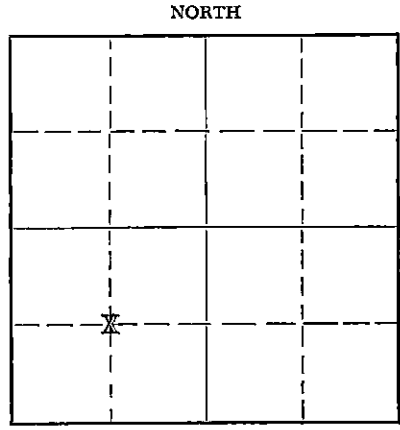

Locate well correctly on above Section Plat

If a producing well is abandoned, date of last production. Dryhole 19  
Was permission obtained from the Conservation Division or its agents before plugging was commenced? Yes

Name of Conservation Agent who supervised plugging of this well M. A. Rives  
Producing formation Dryhole Depth to top Bottom Total Depth of Well 6240 Feet  
Show depth and thickness of all water, oil and gas formations.

OIL, GAS OR WATER RECORDS

CASING RECORD

FORMATION	CONTENT	FROM	TO	SIZE	PUT IN	PULLED OUT
				13 3/8	521	None
				8 5/8	2593	None

Describe in detail the manner in which the well was plugged, indicating where the mud fluid was placed and the method or methods used in introducing it into the hole. If cement or other plugs were used, state the character of same and depth placed, from feet to feet for each plug set.

Hole filled with heavy mud to 15' of surface, cement to surface.

NOTE: Mr. Rives approved plugging of well in this manner due to the possibility of United Producing re-entering well.

RECEIVED  
STATE CORPORATION COMMISSION  
JUN 26 1959  
CONSERVATION DIVISION  
Wichita, Kansas

(If additional description is necessary, use BACK of this sheet)  
Name of Plugging Contractor United Producing Company, Inc.  
Address Drawer 30, Liberal, Kansas

STATE OF KANSAS, COUNTY OF SEWARD, ss.  
L. S. BROWN (employee of owner) or (owner or operator) of the above-described well, being first duly sworn on oath, says: That I have knowledge of the facts, statements, and matters herein contained and the log of the above-described well as filed and that the same are true and correct. So help me God.

(Signature) L. S. Brown  
Drawer 30, Liberal, Kansas (Address)

SUBSCRIBED AND SWORN to before me this 23rd day of June, 1959

Lila J. Brewer Notary Public.

My commission expires 1-30-60

PLUGGING  
FILE SEC. 2 T. 35 R. 30 W  
BOOK PAGE 38 LINE 11

C SW  
 Sec. 2-35S-30W  
 Meade County, Kansas

A. W. ADAMS WELL NO. 1

CONTRACTOR: The R. W. Rine Drilling Co.

STARTED: August 15, 1958

COMPLETED: September 15, 1958

L O G

Surface, Sand & Clay	0' - 400'	Syfo. @200' 1/4°
Clay, Shells & Red Bed	400' - 529'	13-3/8" Csg. @521' W/500 Sk.
Red Bed	529' - 1180'	Syfo. @770' 1°, @1018' 2°
Shale & Shells	1180' - 1317'	Syfo. @1230' 1-1/2°
Red Bed, Shale & Shells	1317' - 1635'	Syfo. @1550' 1°
Red Bed	1635' - 1760'	
Shale & Gyp	1760' - 1870'	Syfo. @1765' 3/4°
Gyp & Chalk	1870' - 1916'	
Anhydrite & Shale	1916' - 2095'	
Anhydrite	2095' - 2462'	Syfo. @2100' 2°, @2350' 2°
Anhydrite & Lime	2462' - 2593'	Syfo. @2400' 2°
Lime	2593' - 3010'	8-5/8" Csg. @2593' W/500 Sx.
Lime & Shale	3010' - 3142'	Syfo. @2691' 2°, @2781' 2-3/4°
Lime	3142' - 3657'	Syfo. @2850' 1-1/2°, @2983' 2°
Lime & Shale	3657' - 4090'	
Shale	4090' - 4370'	Syfo. @3185' 2-3/4°, @3320' 2-3/4°
Lime	4370' - 4442'	Syfo. @3450' 2-1/4°, 3575' 2-1/2°
Lime & Shale	4442' - 4688'	Syfo. @3670' 2-1/2°, @3920' 2-1/4°
Lime	4688' - 4747'	Syfo. @4040' 2-1/2°
Lime & Shale	4747' - 4821'	Syfo. @4125' 2°, @4245' 1-1/2°
Lime & Chert	4821' - 4870'	Syfo. @4400' 1-1/4°
Lime	4870' - 5108'	
Lime & Chert	5108' - 5136'	Syfo. @4865' 3°
Lime	5136' - 5525'	Syfo. @4865' 3°, @5000' 2-3/4°
Shale & Lime	5525' - 5586'	Syfo. @5135' 2-1/2°
Lime, Shale & Sand	5586' - 5652'	Syfo. @5300' 1-3/4°, @5400' 1-1/2°
Lime & Shale	5652' - 5769'	Syfo. @5500' 1°
Shale & Sand	5769' - 5824'	Syfo. @5655' 1-1/4°
Sand, Shale & Lime	5824' - 5857'	Syfo. @5765' 3/4°
Lime	5857' - 5880'	
Shale & Lime	5880' - 6011'	Syfo. @5857' 1-1/2°
Lime	6011' - 6100'	
Lime & Shale	6100' - 6129'	Syfo. @6010' 1-1/2°
Lime	6129' - 6184'	Syfo. @6110' 1-1/4°
Lime & Shale	6184' - 6230'	
Lime	6230' - <del>6230</del> 6240'	

T. D.  
 D. A.

STATE OF KANSAS )  
 COUNTY OF SEDGWICK ) ss

I, R. M. Green, do hereby certify that the above is a true and accurate log of the Adams Well No. 1, located C SW of Sec. 2-35S-30W, Meade County, Kansas.

PLUGGING  
 FILE SEC 2 T 35 R 30W  
 BOOK PAGE 38 LINE 11

*R. M. Green*  
 Secretary - Treasurer

Subscribed and sworn to before me this 20th day of September, 1958.

My Commission Expires: 6/14/62

*Lawrence E. Baker*  
 Notary Public