

WELL PLUGGING RECORD

Give All Information Completely
Make Required Affidavit
Mail or Deliver Report to:
Conservation Division
State Corporation Commission
211 No. Broadway
Wichita, Kansas

Meade County, Sec 1, Twp. 35 Rge. (E) 30 (W)

Location as "NE/CNW/SW" or footage from lines NW SW

Lease Owner Colorado Oil and Gas Corporation

Lease Name Adams Well No. G-1

Office Address Box 158, Liberal, Kansas 67901

Character of Well (completed as Oil, Gas or Dry Hole) Gas

Date well completed 3 - 1 19 66

Application for plugging filed 4 - 15 19 66

Application for plugging approved 4 - 18 19 66


Plugging commenced 6 - 1 19 66

Plugging completed 6 - 4 19 66

Reason for abandonment of well or producing formation Non commercial

If a producing well is abandoned, date of last production - 19

Was permission obtained from the Conservation Division or its agents before plugging was commenced? Yes

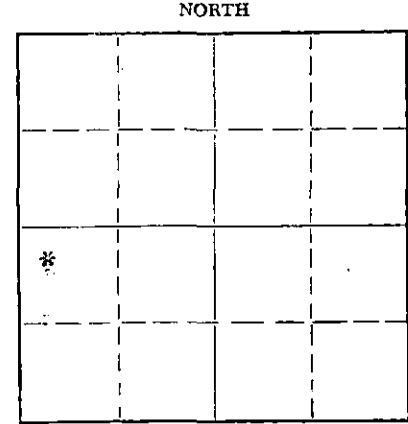

Name of Conservation Agent who supervised plugging of this well Edgar Eves

Producing formation Depth to top Bottom Total Depth of Well 6310' Feet

Show depth and thickness of all water, oil and gas formations.

OIL, GAS OR WATER RECORDS

CASING RECORD

| FORMATION | CONTENT | FROM | TO | SIZE | PUT IN | PULLED OUT |
|-----------|---------|------|----|------|--------|------------|
| | | | | | | |
| | | | | | | |
Describe in detail the manner in which the well was plugged, indicating where the mud fluid was placed and the method or methods used in introducing it into the hole. If cement or other plugs were used, state the character of same and depth placed, from feet to feet for each plug set.

Mixed 20 sacks cement on bottom of hole, top cement to 5650'.

Shot casing, recovered 3401' of 5-1/2". Ran 35 sacks cement

plug 700' to 600'. Filled hole with mud to 45'. Ran 5 sacks

of cement plug 45' to 3'. Cut casing and welded cap on top of

casing.

RECEIVED
STATE CORPORATION COMMISSION

JUN 22 1966

CONSERVATION DIVISION
Wichita Kansas

(If additional description is necessary, use BACK of this sheet)

Name of Plugging Contractor Sargent's Casing Pulling Company
Address 121 West 9th Street, Liberal, Kansas 67901

STATE OF Kansas, COUNTY OF Seward, ss.
L. H. Walters (employee of owner) or (owner or operator) of the above-described

well, being first duly sworn on oath, says: That I have knowledge of the facts, statements, and matters herein contained and the log of the above-described well as filed and that the same are true and correct. So help me God.

(Signature) L. H. Walters

P.O. Box 158, Liberal, Kansas 67901 (Address)

SUBSCRIBED AND SWORN TO before me this 21 st. day of June, 1966

William B. Claunch Notary Public.

My commission expires 11/1/66

Orig: Corp. Comm.
cc: A.J. Smith
Wichita
File