

STATE OF KANSAS
STATE CORPORATION COMMISSION

WELL PLUGGING RECORD

Give All Information Completely
Make Required Affidavit
Mail or Deliver Report to
Conservation Division
State Corporation Comm.
245 North Water
Wichita, KS 67202

Seward County, Sec. 18 Twp. 35S Rge. 31 1/4

Location as "NE/CNW/SW" or footage from lines

75' N of C. NW 1/4

Lease Owner (Alice Lofland) Ran Picks, Jr.

Lease Name Lofland Well No. 18-A

Office Address 400 City Ctr. Okla City, Okla. 73102

Character of Well (Completed as Oil, Gas or Dry Hole)

Dry Hole

Date Well completed March 13 1978

Application for plugging filed March 14 1978

Application for plugging approved March 14 1978

Plugging commenced March 14 1978

Plugging completed March 14 1978


Reason for abandonment of well or producing formation

Dry Hole

If a producing well is abandoned, date of last production

N/A 19

Was permission obtained from the Conservation Division or its agents before plugging was commenced? Yes

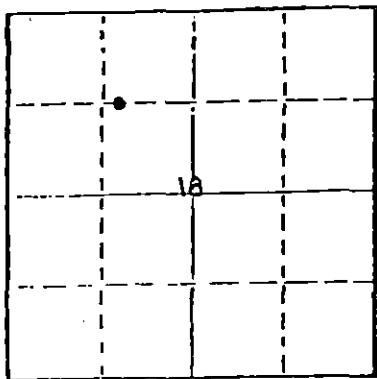

Locate well correctly on above Section Plat

Name of Conservation Agent who supervised plugging of this well

Producing formation N/A Depth to top — Bottom — Total Depth of Well 6350'

Show depth and thickness of all water, oil and gas formations.

OIL, GAS OR WATER RECORDS

CASING RECORD

FORMATION	CONTENT	FROM	TO	SIZE	PUT IN	PULLED OUT
<u>None</u>						

Describe in detail the manner in which the well was plugged, indicating where the mud fluid was placed and the method or methods used in introducing it into the hold. If cement or other plugs were used, state the character of same and depth placed, from 1450' feet to surface feet for each plug set.

First plug at 1450' with 50 sx cement

40' to ground level with 10 sx cement

5 sx in. rat hole

5 sx in. mouse hole

RECEIVED
STATE CORPORATION COMMISSION

JUN 16 1978

(If additional description is necessary, use BACK of 1721B, sheet)

Name of Plugging Contractor Zenith Drilg. - 200 W. Douglas
Wichita, Kansas

STATE OF Oklahoma COUNTY OF Oklahoma, ss.
Shayne Bradshaw (employee of owner) or (owner or operator)
of the above-described well, being first duly sworn on oath, says: That I have knowledge of the facts, statements, and matters herein contained and the log of the above-described well as filed and that the same are true and correct. So help me God.

(Signature) Shayne Bradshaw
400 City Ctr - Okla City, Okla. 73102
(Address)

SUBSCRIBED AND SWORN TO before me this 13th day of June, 1978

Sandra J. Smith
Notary Public.

My commission expires May 24, 1981

WELL LOG

COMPANY Ran Ricks, Jr.

SEC. 18-35S-31W

FARM Lofland

NO. 1-18A

LOC. 75' N of C NW/4


TOTAL DEPTH 6350'

COUNTY Seward

COMM. 2-27-78

COMP. 3-13-78

CONTRACTOR ZENITH DRILLING CORPORATION, INC.

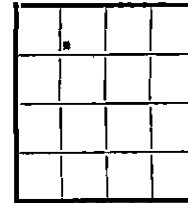

CASING
1443' of 8 5/8", 24# casing, cemented with
750' sacks of cement.

ELEVATION

PRODUCTION

FIGURES INDICATE BOTTOM OF FORMATIONS

210	Sand & Red Bed
1460	Red Bed
1880	Red Bed & Anhydrite
2650	Anhydrite
4100	Dolomite
4250	Lime, Shale & Dolomite
6350	Lime & Shale

PLUGGING INFORMATION

1st Plug 50 sacks @ 1400'
 2nd Plug 10 sacks @ 40' - 3'

5 sacks in rat hole
 5 sacks in mouse hole

Job Complete @ 5:00 P.M. 3-13-78

RECEIVED
 STATE CORPORATION COMMISSION
 JUN 19 1978
 CONSERVATION DIVISION
 Wichita, Kansas

State of KANSAS }
 County of SEDGWICK } ss

I, Emmet E. Hall of Zenith Drilling Corporation, Inc.

upon oath state the above and foregoing is a true and correct copy of the log of the Lofland #1-18 well.

Emmet E. Hall

Subscribed and sworn to before me this 17th day of March, 1978.

My Commission Expires: December 15, 1980

Sharon R. Allen
 Sharon R. Allen NOTARY PUBLIC