


STATE OF KANSAS  
STATE CORPORATION COMMISSION

WELL PLUGGING RECORD

Give All Information Completely  
Make Required Affidavit  
Mail or Deliver Report to  
Conservation Division  
State Corporation Comm.  
245 North Water  
Wichita, KS 67202

Seward County. Sec. 17 Twp. 35S Rge. 31W E/W  
Location as "NE/CNW $\frac{1}{4}$ SW $\frac{1}{4}$ " or footage from lines  
560 FNL 560 FWL  
Lease Owner Kimbark Oil & Gas Company  
Lease Name Alice Well No. 2  
Office Address 1580 Lincoln St, Suite 700, Denver, Co 80203  
Character of Well (Completed as Oil, Gas or Dry Hole)

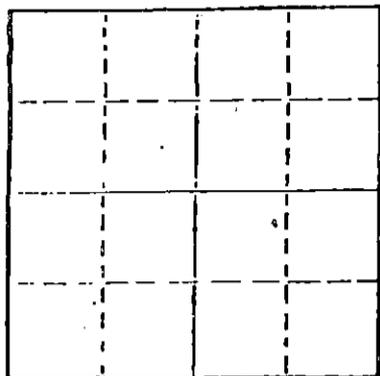

Locate well correctly on above  
Section Plot

Dry  
Date Well completed 3-1 1982  
Application for plugging filed 2-28 1982  
Application for plugging approved 2-28 1982  
Plugging commenced 3-1- 1982  
Plugging completed 3-1 1982  
Reason for abandonment of well or producing formation

Dry  
If a producing well is abandoned, date of last production 19

Was permission obtained from the Conservation Division or its agents before plugging was commenced? Yes

Name of Conservation Agent who supervised plugging of this well Paul Luthi  
Producing formation Depth to top Bottom Total Depth of Well 5650  
Show depth and thickness of all water, oil and gas formations.

OIL, GAS OR WATER RECORDS

CASING RECORD

FORMATION	CONTENT	FROM	TO	SIZE	PUT IN	PULLED OUT
		0	50	20		
			1520	8 5/8		

Describe in detail the manner in which the well was plugged, indicating where the mud fluid was placed and the method or methods used in introducing it into the hold. If cement or other plugs were used, state the character of same and depth placed, from feet to feet for each plug set.

Plugged:  
40 sacks @ 1500  
35 sacks @ 600  
15 sacks @ 40  
10 sacks in rathole; 10 sacks in mousehole.  
Completed 3-1-82 @ 1:45AM  
Cemented by Halliburton

(If additional description is necessary, use BACK of this sheet)

Name of Plugging Contractor DaMac Drilling Inc.

STATE OF Kansas COUNTY OF Barton, ss.  
Martha J. McKown (employee of owner) or (owner or operator)  
of the above-described well, being first duly sworn on oath, says: That I have knowledge of the facts, statements, and matters herein contained and the log of the above-described well as filed and that the same are true and correct. So help me God.

(Signature) Martha J. McKown  
Box 1164, Great Bend, Ks. 67530  
(Address)

SUBSCRIBED AND SWORN TO before me this 1st day of March, 1982

My commission expires

RECEIVED  
STATE CORPORATION COMMISSION  
APR - 1 1982

NOTARY PUBLIC  
VADA L. SULLIVAN  
Barton County, Kansas  
My Appt. Exp. 4-30-84

Vada L. Sullivan  
Notary Public.

CONSERVATION  
Wichita, Kansas

15-175-20599-0000

# WELL LOG

COMPANY Kimbark Oil & Gas Company

SEC. 17 T. 35S R. 31W

FARM Alice NO. 2


LOC. 560 FNL 560 FWL

TOTAL DEPTH 5650 RTD

COUNTY Seward

COMM. 2-13-82 COMP. 3-1-82

CONTRACTOR DaMac Drilling Inc.

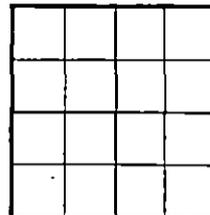

CASING 20" set @ 50  
8 5/8" set @ 1520

ELEVATION

PRODUCTION P&A

FIGURES INDICATE BOTTOM OF FORMATIONS

Sand	0	1450
RedBed, Shale	1450	1520
Shale	1520	1927
Lime, Shale	1927	5650 RTD

RECEIVED  
STATE CORPORATION COMMISSION  
APR - 1 1982  
CONSULTING  
WICHITA, KAN.

State of Kansas }  
County of Barton } ss

I, Martha J. McKown of DaMac Drilling Inc.

upon oath state the above and foregoing is a true and correct copy of the log of the Alice #2 well.

Martha J. McKown

Subscribed and sworn to before me this 28th day of February 19 82

My Commission Expires: \_\_\_\_\_

VADA L. SULLIVAN  
Barton County, Kansas  
NOTARY PUBLIC  
My Appt. Exp. 6-30-84

Vada L. Sullivan