


STATE OF KANSAS
STATE CORPORATION COMMISSION

WELL PLUGGING RECORD

Give All Information Completely
Make Required Affidavit
Mail or Deliver Report to:
Conservation Division
State Corporation Commission
800 Bitting Building
Wichita, Kansas

NORTH

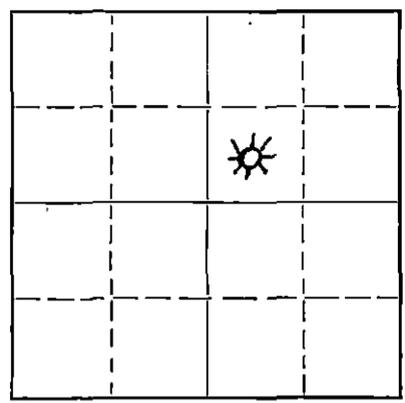

Locate well correctly on above Section Plat

Seward County, Sec. 7 Twp. 35 Rge. 31 (E) (W)
Location as "NE/CNW $\frac{1}{4}$ SW $\frac{1}{4}$ " or footage from lines Cen SW/4 NE/4
Lease Owner J.M. Huber Corp.
Lease Name Baty Well No. 1
Office Address Box 978 Liberal, Kansas
Character of Well (completed as Oil, Gas or Dry Hole) Dry hole
Date well completed 1-3-54 19
Application for plugging filed 1-4-54 19
Application for plugging approved 1-4-54 19
Plugging commenced 1-4-54 19
Plugging completed 1-4-54 19
Reason for abandonment of well or producing formation Dry hole

If a producing well is abandoned, date of last production 19
Was permission obtained from the Conservation Division or its agents before plugging was commenced? yes

Name of Conservation Agent who supervised plugging of this well M.A. Rives
Producing formation Depth to top Bottom Total Depth of Well 6420 Feet
Show depth and thickness of all water, oil and gas formations.

OIL, GAS OR WATER RECORDS

CASING RECORD

Formation	Content	From	To	Size	Put In	Pulled Out
				13 3/8"	600'	none
				9 5/8"	2400'	none

Describe in detail the manner in which the well was plugged, indicating where the mud fluid was placed and the method or methods used in introducing it into the hole. If cement or other plugs were used, state the character of same and depth placed, from feet to feet for each plug set.

Filled with mud laden fluid from 6420' to 600'
Set cementing plug, $\frac{1}{2}$ sack hulls & 30 sks. cement at 600'. Filled with mud laden fluid to 40'. Set cementing plug, $\frac{1}{2}$ sack hulls at 40'. Filled with 10 sacks cement to top of hole.

(If additional description is necessary, use BACK of this sheet)

Name of Plugging Contractor J.M. Huber Corp.
Address Box 978 Liberal, Kansas

STATE OF Kansas, COUNTY OF Seward, ss.
R.E. McDaniel (employee of owner) or (owner or operator) of the above-described well,

being first duly sworn on oath, says: That I have knowledge of the facts, statements, and matters herein contained and the log of the above-described well as filed and that the same are true and correct. So help me God.

(Signature) R.E. McDaniel

Box 978, Liberal, Kansas (Address)

SUBSCRIBED AND SWORN TO before me this 6 day of January, 1954
Notary Public.

My commission expires July 27 1957

PLUGGING
FILE SEC 7 T 35 R 31 W
BOOK PAGE 6 LINE 2

6-51-20M
1-7-54

DRILLER'S LOG

Well Name O #1. Baty

Well Location - Cen SW NE Sec 7 Twp 35S Rge 31W
Seward Co., Kansas

Lease Owner - J.M. Huber Corp. Box 978 Liberal, Kansas

Date Commenced - 11-17-53

Date Completed - 1-4-54

Casing Data:

13 3/8 - 600' Cemented with 250 sks.

9 5/8 - 2400' Cemented with 1000 sks.

Character of well - Dry Hole

Formation	Depth
Surface sand & shale	0-570
Redbed	570-645
Redbed & Gyp	645-1732
Shale & Anhydrite	1732-2382
Lime & Anhydrite	2382-2631
Lime	2631-2894
Lime & Shale	2894-4520
Lime	4520-4667
Lime & Chert	4667-4796
Lime	4796-5703
Lime & Shale	5703-5950
Shale	5950-5997
Lime & Shale	5997-6320

Total Depth 6320'

State of Kansas, County of Seward, ss

R.E. McDaniel, employee of owner of the above described well, being first duly sworn on oath, says: That I have knowledge of the facts, statements, and matters herein contained and the log of the above described well as filed and that the same are true and correct.

R.E. McDaniel

R.E. McDaniel
Petroleum Engr.
Box 978 Liberal, Kans.

Subscribed and sworn to before me this 14 day of January 1954.

My commission expires 7-27-57

J. K. Pender
Notary Public

PLUGGING
FILE SEC 7 T 35 R 31W
BOOK PAGE 6 LINE 7