


STATE OF KANSAS
STATE CORPORATION COMMISSION

WELL PLUGGING RECORD

Give All Information Completely
Make Required Affidavit
Mail or Deliver Report to
Conservation Division
State Corporation Comm.
245 North Water
Wichita, KS 67202

Seward County, Sec. 5 Twp. 35S Rge. 31W E/W
Location as "NE/CNW $\frac{1}{4}$ /SW $\frac{1}{4}$ " or footage from lines
C NW

Lease Owner Kennedy & Mitchell, Inc.
Lease Name Risley Well No. 45-695
Office Address p. O. Box 1869 - Liberal, KS 67901
Character of Well (Completed as Oil, Gas or Dry Hole) dry
Date Well completed 4-6 1982
Application for plugging filed 4-8 1982
Application for plugging approved 4-8 1982
Plugging commenced 4-9 1982
Plugging completed 4-9 1982
Reason for abandonment of well or producing formation dry

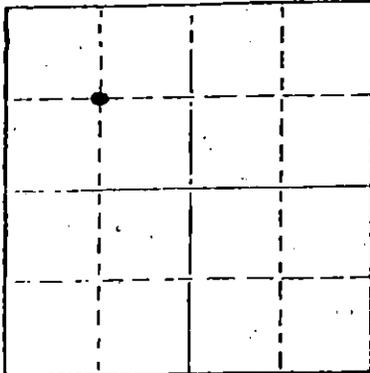

Locate well correctly on above
Section Plot

If a producing well is abandoned, date of last production 19

Was permission obtained from the Conservation Division or
its agents before plugging was commenced? yes

Name of Conservation Agent who supervised plugging of this well Clarence Thomas, Jr.
Producing formation Depth to top Bottom Total Depth of Well
Show depth and thickness of all water, oil and gas formations.

OIL, GAS OR WATER RECORDS

CASING RECORD

FORMATION	CONTENT	FROM	TO	SIZE	PUT IN	PULLED OUT
			1526	8-5/8	1526	0

Describe in detail the manner in which the well was plugged, indicating where the mud fluid was placed and the method or methods used in introducing it into the hold. If cement or other plugs were used, state the character of same and depth placed, from feet to feet for each plug set.

plugged as follows:

50 sx 1480'

25 sx 400'

10 sx 40'

10 sx each rat hole & mouse hole - cut off pipe 3' below surface & welded on ID plate

(If additional description is necessary, use BACK of this sheet)

Name of Plugging Contractor Halliburton


STATE OF Kansas COUNTY OF Seward, ss.
J. M. Logan (employee of owner) or (owner or operator)
of the above-described well, being first duly sworn on oath, says: That I have knowledge of the facts, statements, and matters herein contained and the log of the above-described well as filed and that the same are true and correct. So help me God.

(Signature) J.M. Logan

Box 1869 - Liberal, KS 67901
(Address)

SUBSCRIBED AND SWORN TO before me this 25 day of June, 1982

My commission expires

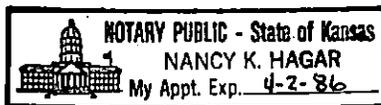

Nancy K. Hagar
RECEIVED Notary Public.
STATE CORPORATION COMMISSION

JUN 28 1982

CONSERVATION DIVISION
Wichita Kansas

Name of lowest fresh water producing stratum Ogalalla 15-175-20602-0000
 Estimated height of cement behind pipe circ Depth 350'

WELL LOG

SHOW GEOLOGICAL MARKERS, LOGS RUN, OR OTHER DESCRIPTIVE INFORMATION.

Show all important zones of porosity and contents thereof; cored intervals, and all drill-stem tests, including depth interval tested, cushion used, time tool open, flowing and shut-in pressures, and recoveries.

FORMATION DESCRIPTION, CONTENTS, ETC.	TOP	BOTTOM	NAME	DEPTH
Surface sand	0	605		
Red Bed, Sand	605	1526		
Anhydrite	1526	1920		
Red bed	1920	2450		
Shale	2450	3340		
Sahle, Dolomite	3340	3793		
Shale, Lime	3793	6500 TD		

USE ADDITIONAL SHEETS, IF NECESSARY, TO COMPLETE WELL RECORD.

A F F I D A V I T

STATE OF Kansas, COUNTY OF Seward SS,

Frank Burke OF LAWFUL AGE, BEING FIRST DULY SWORN UPON HIS


OATH, DEPOSES AND SAYS:

THAT HE IS Agent FOR Kennedy & Mitchell, Inc.
 OPERATOR OF THE Risley LEASE, AND IS DULY AUTHORIZED TO MAKE THIS
 AFFIDAVIT FOR AND ON BEHALF OF SAID OPERATOR, THAT WELL NO. 45-695 ON SAID LEASE HAS
 BEEN COMPLETED AS OF THE 7 DAY OF April, 19 82, AND THAT ALL
 INFORMATION ENTERED HEREIN WITH RESPECT TO SAID WELL IS TRUE AND CORRECT.

FURTHER AFFIANT SAITH NOT.

(S) Frank Burke Agent

SUBSCRIBED AND SWORN TO BEFORE ME THIS 29 DAY OF April, 19 82

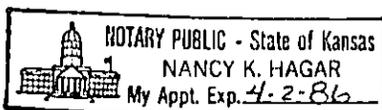

Nancy K. Hagar
 NOTARY PUBLIC

MY COMMISSION EXPIRES: 4-2-86