

STATE OF KANSAS
STATE CORPORATION COMMISSION

WELL PLUGGING RECORD

Give All Information Completely
Make Required Affidavit
Mail or Deliver Report to
Conservation Division
State Corporation Comm.
245 North Water
Wichita, KS 67202

Morton County, Sec. 20 Twp. 34S Rge. 43 NW
Location as "NE/CNW/SW" or footage from lines
90' FSL & 1320' FEL

Lease Owner Anadarko Production Company
Lease Name INTERSTATE UNIT Well No. 93

Office Address P. O. Box 351, Liberal, Kansas 67901
Character of Well (Completed as Oil, Gas or Dry Hole)


DRY HOLE

Date Well completed 12/2 1981
Application for plugging filed 12/5 1981
Application for plugging approved verbal 12/1 1981
Plugging commenced 12/1 1981
Plugging completed 12/1 1981

Reason for abandonment of well or producing formation
Due to loss of circulation and tools in hole

If a producing well is abandoned, date of last production
19

Was permission obtained from the Conservation Division or
its agents before plugging was commenced? yes

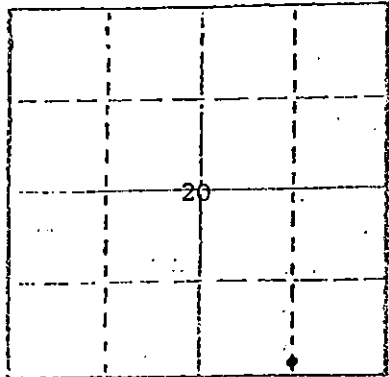

Locate well correctly on above
Section Plat

Name of Conservation Agent who supervised plugging of this well Mr. Clarence Thomas
Producing formation Depth to top Bottom Total Depth of Well 1179'
Show depth and thickness of all water, oil and gas formations.

OIL, GAS OR WATER RECORDS

CASING RECORD

FORMATION	CONTENT	FROM	TO	SIZE	PUT IN	PULLED OUT
				8-5/8"	112'	-0-

Describe in detail the manner in which the well was plugged, indicating where the mud fluid
was placed and the method or methods used in introducing it into the hold. If cement or other
plugs were used, state the character of same and depth placed, from feet to
feet for each plug set.

Spotted 30 sxs cmt plug @ 500-450', Perf DP 436-38, 5 holes, Spotted 70 sxs cmt plug 430-
360'. Ran 3 jt 8-5/8" 24# csg, btm @ 112', cmt w/375 sxs common, ran 40' of 1" pipe, cmt
outside of 8-5/8 csg w/100 sxs common, ran 1" pipe and cmt rathole w/25 sxs common cmt.

RECEIVED
STATE CORPORATION COMMISSION
12-23-81
DEC 23 1981
CONSERVATION DIVISION
Wichita, Kansas

(If additional description is necessary, use BACK of this sheet)

Name of Plugging Contractor Wakefield Drilling Co., Inc.

STATE OF KANSAS COUNTY OF SEWARD, ss.

Paul Campbell (employee of owner) or (owner or operator)
of the above-described well, being first duly sworn on oath, says: That I have knowledge of
the facts, statements, and matters herein contained and the log of the above-described well
as filed and that the same are true and correct. So help me God.

(Signature) Paul Campbell
P. O. Box 351, Liberal, Kansas 67901
(Address)

SUBSCRIBED AND SWORN TO before me this 16th day of December, 1981

STATE NOTARY PUBLIC
BEVERLY J. WILLIAMS
Seward County, Kansas
My Comm. Expires November 21, 1982

Beverly J. Williams
Notary Public.

My commission expires November 21, 1982

KANSAS

WELL COMPLETION REPORT AND DRILLER'S LOG

API No. 15 — 129 — 20,563
 County Number

Operator
 Anadarko Production Company

Address
 P. O. Box 351, Liberal, Kansas 67901

Well No. 93 Lease Name INTERSTATE UNIT

Footage Location
 90 feet from (N) (S) line 1320 feet from (E) (W) line


Principal Contractor Geologist
 Wakefield Drilling Co. Mr. Jim Druyff

Spud Date Date Completed Total Depth P.B.T.D.
 10/27/81 12/2/81 1179' -----

Directional Deviation Oil and/or Gas Purchaser
 not applicable DRY HOLE

S. 20 T. 34S R. 43 xE W
 Loc. 90' FSL & 1320' FEL
 County Morton

640 Acres
 N

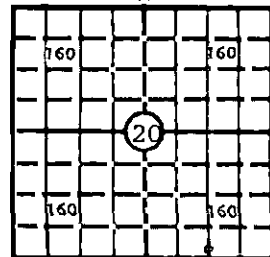

Elev.: Gr. 3481'
 DF 3486' KB 3487'

CASING RECORD

Report of all strings set — surface, intermediate, production, etc.

Purpose of string	Size hole drilled	Size casing set (in O.D.)	Weight lbs/ft.	Setting depth	Type cement	Sacks	Type and percent additives
Surface	12-1/4"	8-5/8"	24#	112'	Common	475	3% CaCl

LINER RECORD

PERFORATION RECORD

Top, ft.	Bottom, ft.	Sacks cement	Shots per ft.	Size & type	Depth interval

TUBING RECORD

Size	Setting depth	Packer set at

ACID, FRACTURE, SHOT, CEMENT SQUEEZE RECORD

Amount and kind of material used	Depth interval treated

INITIAL PRODUCTION

Date of first production	Producing method (flowing, pumping, gas lift, etc.)
DRY HOLE	
RATE OF PRODUCTION PER 24 HOURS	Oil Gas Water Gas-oil ratio
	bbis. MCF bbis. CFPB
Disposition of gas (vented, used on lease or sold)	Producing interval(s)

INSTRUCTIONS: As provided in KCC Rule 82-2-125, within 90 days after completion of a well, one completed copy of this Drillers Log shall be transmitted to the State Geological Survey of Kansas, 4150 Monroe Street, Wichita, Kansas 67209. Copies of this form are available from the Conservation Division, State Corporation Commission, 245 No. Water, Wichita, Kansas 67202. Phone AC 316-522-2206. If confidential custody is desired, please note Rule 82-2-125. Drillers Logs will be an open file in the Oil and Gas Division, State Geological Survey of Kansas, Lawrence, Kansas 66044.

Operator
Anadarko Production Company

DESIGNATE TYPE OF COMP.: OIL, GAS,
DRY HOLE, SWDW, ETC.:

Well No.

93

Lease Name

INTERSTATE UNIT

DRY HOLE

S 20 T 34S R 43W^E
W

WELL LOG

Show all important zones of porosity and contents thereof; cored intervals, and all drill-stem tests, including depth interval tested, cushion used, time tool open, flowing and shut-in pressures, and recoveries.

SHOW GEOLOGICAL MARKERS, LOGS RUN,
OR OTHER DESCRIPTIVE INFORMATION.

FORMATION DESCRIPTION, CONTENTS, ETC.

TOP

BOTTOM


NAME

DEPTH

HOLE LOSS DUE TO LOSS OF CIRCULATION AND TOOLS IN HOLE

USE ADDITIONAL SHEETS, IF NECESSARY, TO COMPLETE WELL RECORD.

Date Received

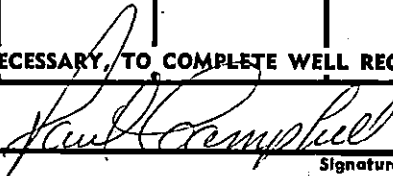
Signature

Paul Campbell, Division Operations Manager

Title

December 15, 1981

Date