


15-129-10486-0000

STATE OF KANSAS
STATE CORPORATION COMMISSION

WELL PLUGGING RECORD

Give All Information Completely
Make Required Affidavit
Mail or Deliver Report to:
Conservation Division
State Corporation Commission
800 Bittling Building
Wichita, Kansas

Morton County. Sec. 19 Twp. 34 Rge. (E) 43 (W)
Location as "NE/CNW $\frac{1}{4}$ SW $\frac{1}{4}$ " or footage from lines C SE $\frac{1}{2}$ NE $\frac{1}{2}$
Lease Owner Panhandle Eastern Pipe Line Company
Lease Name Humble "B" Well No. 02
Office Address 300 North Lincoln, Liberal, Kansas
Character of Well (completed as Oil, Gas or Dry Hole) Dry Hole
Date well completed August 31, 1956
Application for plugging filed August 31, 1956
Application for plugging approved August 31, 1956
Plugging commenced August 31, 1956
Plugging completed September 1, 1956
Reason for abandonment of well or producing formation Dry Hole

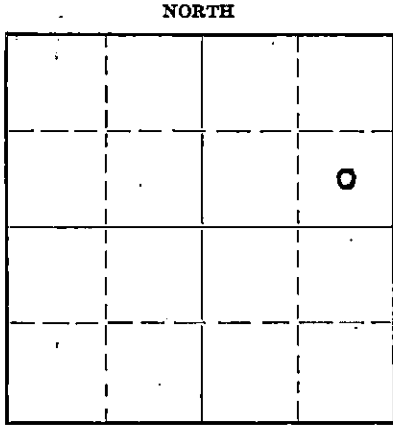

Locate well correctly on above
Section Flat

If a producing well is abandoned, date of last production -- 19
Was permission obtained from the Conservation Division or its agents before plugging was commenced? Yes

Name of Conservation Agent who supervised plugging of this well M. A. Rives, Box 8, Pratt, Kansas
Producing formation NA Depth to top NA Bottom NA Total Depth of Well 4250 Feet
Show depth and thickness of all water, oil and gas formations.

OIL, GAS OR WATER RECORDS

CASING RECORD

Formation	Content	From	To	Size	Put In	Pulled Out
Upper Morrow	Salt Water	4212	4224	10-3/4"	99'	
				7"	1132'	

Describe in detail the manner in which the well was plugged, indicating where the mud fluid was placed and the method or methods used in introducing it into the hole. If cement or other plugs were used, state the character of same and depth placed, from feet to feet for each plug set.

Cement plugs were placed by the pump and plug method as follows:
50 sacks cement on bottom
25 sacks cement @ 600'
25 sacks cement at top (reached surface)

The interval between plugs was pumped full of heavy mud-laden fluid

(If additional description is necessary, use BACK of this sheet)

Correspondence regarding this well should be addressed to Panhandle Eastern Pipe Line Company
Address Box #351, Liberal, Kansas

STATE OF Kansas, COUNTY OF Seward, ss.
B. J. Delap (employee of owner) or (owner or operator) of the above-described well,
being first duly sworn on oath, says: That I have knowledge of the facts, statements, and matters herein contained and the log of the above-described well as filed and that the same are true and correct. So help me God.

(Signature) B. J. Delap

Box #351, Liberal, Kansas (Address)

SUBSCRIBED AND SWORN to before me this 12th day of September, 1956
Raymond R. Roper Notary Public.

My commission expires
NOVEMBER 23, 1959

PLUGGING
FILE SEC 19 T 34 R 43W
BOOK PAGE 97 LINE 8

9-13-56

DRILLERS LOG

WELL NAME: Humble "B"-02
 WELL LOCATION: Center of the SE
 NE of Section 19, Township 34,
 Range 43, Morton County, Kansas
 (1980' South of North Section
 Line and 660' West of East Section
 Line)
 COUNTY: Morton STATE: Kansas
 Company: Panhandle Eastern Pipe Line Company
 Contractor: Nye & Snell Drilling Company
 Elevation: 3496.07'

Original Open Flow: Dry Hole
 Deliverability After Acid: "
 Rock Pressure: "
 Source of Data: Driller's Report
 Drilling Commenced: August 16, 1956
 Drilling Completed: August 31, 1956
 Well Completed: August 31, 1956
 Well Connected: Dry Hole

ROTARY LOG

DESCRIPTION OF FORMATION	TOP	BOTTOM
Surface Soil & Sand	0 0'	45'
Sand and Red Bed.	45'	98'
Red Bed	98'	168'
Red Bed and Shale	168'	445'
Red Bed	445'	805'
Shale	805'	1126'
Anhydrite	1126'	1341'
Shale	1341'	2274'
Lime & Shale	2274'	4196'
Lime Shale & Sand	4196'	4250' TD.

10-3/4" Conductor pipe was set @ 99', w/100 sx pozmix cement.

7" surface casing was set @ 1132', w/700 sx pozmix cement.

FORMATION TOPS:

Upper Morrow 4212'

PERFORATIONS: None

WELL TREATMENT RECORD: Well was a dry hole, and was not treated.

RECORDED
 STATE GEOLOGICAL SURVEY
 SEP 13 1956

PLUGGING
 FILE SEC. 19 T. 34 R. 43W
 BOOK PAGE 97 LINE 8