


STATE OF KANSAS
STATE CORPORATION COMMISSION

WELL PLUGGING RECORD

Give All Information Completely
Make Required Affidavit
Mail or Deliver Report to:
Conservation Division
State Corporation Commission
211 No. Broadway
Wichita, Kansas

Morton County. Sec. 17 Twp. 34 Rge. 43 (E) (W)
Location as "NE/CNW/SW" or footage from lines C NE SW
Lease Owner Panhandle Eastern Pipe Line Company
Lease Name Interstate Well No. "B" 05
Office Address Box 351, Liberal, Kansas
Character of Well (completed as Oil, Gas or Dry Hole) Dry Hole
Date well completed March 31, 19 58
Application for plugging filed March 30, 19 58
Application for plugging approved March 30, 19 58
Plugging commenced March 30, 19 58
Plugging completed March 31, 19 58
Reason for abandonment of well or producing formation Dry Hole

NORTH

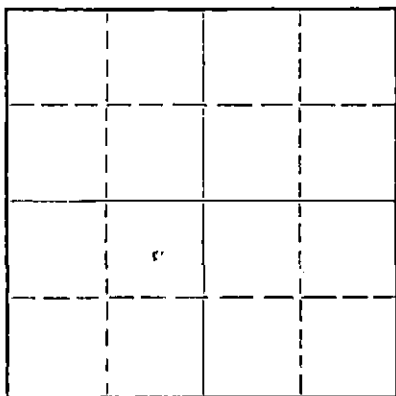

Locate well correctly on above
Section Plat

If a producing well is abandoned, date of last production _____ 19 ____
Was permission obtained from the Conservation Division or its agents before plugging was commenced? Yes

Name of Conservation Agent who supervised plugging of this well Mr. Reives, Garden City, Kansas
Producing formation _____ Depth to top _____ Bottom _____ Total Depth of Well 4438 Feet
Show depth and thickness of all water, oil and gas formations.

OIL, GAS OR WATER RECORDS

CASING RECORD

FORMATION	CONTENT	FROM	TO	SIZE	PUT IN	PULLED OUT
<u>Greenwood</u>		<u>2710</u>	<u>3150</u>	<u>7"</u>	<u>1240'</u>	<u>0</u>

Describe in detail the manner in which the well was plugged, indicating where the mud fluid was placed and the method or methods used in introducing it into the hole. If cement or other plugs were used, state the character of same and depth placed, from _____ feet to _____ feet for each plug set.

Set plugs @ 3175 & cmtd back to 2631 W/100 sx cmt. Set plug @ 700' & cmtd W/15 sx cmt. Filled hole within 35' of top with mud. Then cmtd within 5' of top. And then capped.

RECEIVED
STATE CORPORATION COMMISSION

APR 3 1958

CONSERVATION DIVISION
Wichita, Kansas

(If additional description is necessary, use BACK of this sheet)

Name of Plugging Contractor _____
Address _____

STATE OF Kansas, COUNTY OF Seward, ss.

(employee of owner) or (owner or operator) of the above-described well, being first duly sworn on oath, says: That I have knowledge of the facts, statements, and matters herein contained and the log of the above-described well as filed and that the same are true and correct. So help me God.

(Signature) S. H. Weathercoat

Box 351, Liberal, Kansas
(Address)

SUBSCRIBED AND SWORN TO before me this 8 day of April, 1958

My commission expires April 11 1959

Notary Public.

PLUGGING
REC 17T 34R 43W
BOOK PAGE 91 LINE 32

15-129-10501-0000

DRILLER'S LOG

WELL NAME: Interstate "B" 05; COMPANY OPERATING: Panhandle Eastern Pipe Line Co
 ADDRESS of COMPANY: Box 351, Liberal, Kansas

WELL LOCATION: C $\frac{1}{4}$ NE $\frac{1}{4}$ SW $\frac{1}{4}$,
1980' ft. North of South line,
2040' ft. East of West line; Sec. 17, Twp. 34, Rge. 43, Morton County, Kansas

DRILLING STARTED 3-14, 1958; DRILLING COMPLETED 3-31, 1958
 WELL COMPLETED _____, 19____; WELL CONNECTED _____, 19____

ELEVATION: 3529 ft. Ground Level; CHARACTER OF WELL (Oil, Gas, or Dry Hole) Dry Hole

OIL OR GAS SANDS OR ZONES - PERFORATIONS - ACIDIZING AND FRACTURING INFORMATION					
Name	From	To	No. of Shots	Gallons Used	Kind Used

CASING RECORD

Size	Amount Set	Sacks of Cement	Amount Pulled
7"	1240'	250	0

FORMATION RECORD

Formation	Top	Bottom	Formation	Top	Bottom
Wabaunsee	2516	2716			
Topeka	2716	2955			
Greenwood Lansing	2955	3141			
Lansing	3141				
Cherokee	3839				
Morrow	4156				
Purdy Sand	4241	4253			

RESULTS of INITIAL PRODUCTION TEST: Dry and abandoned

PLUGGING
 FILE SEC 17 T 34 R 43
 BOOK PAGE 91 LINE 32