

STATE OF KANSAS
STATE CORPORATION COMMISSION

Form CP-4


Give All Information Completely
Make Required Affidavit
Mail or Deliver Report to:
Conservation Division
State Corporation Commission
212 No. Market
Wichita, Kansas

WELL PLUGGING RECORD

Morton County, Sec. 17 Twp. 34S Rge. 43W (E) (W)

Location as "NE/CNW&SW&" or footage from lines 660' FNL & 1320' FEL
Lease Owner J. M. Huber Corporation
Lease Name Government Well No. 2(RC)
Office Address P. O. Box 911, Amarillo, Texas
Character of Well (completed as Oil, Gas or Dry Hole) Gas
Date well completed May 29 1966
Application for plugging filed December 15 1969
Application for plugging approved December 18 1969
Plugging commenced December 12 1969
Plugging completed December 12 1969
Reason for abandonment of well or producing formation Unprofitable

NORTH

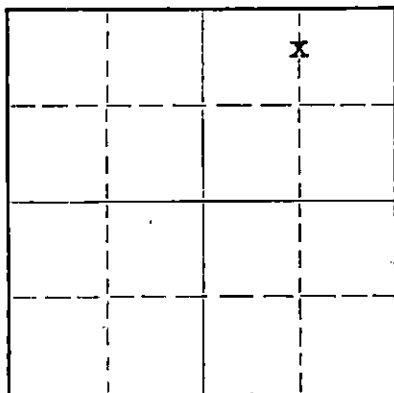

Locate well correctly on above Section Plat

If a producing well is abandoned, date of last production Shut-in 19
Was permission obtained from the Conservation Division or its agents before plugging was commenced? Yes

Name of Conservation Agent who supervised plugging of this well Mr. E. Eves
Producing formation Red Cave Depth to top 1297 Bottom 1304 Total Depth of Well 1328 PBD
Show depth and thickness of all water, oil and gas formations.

OIL, GAS OR WATER RECORDS

CASING RECORD

FORMATION	CONTENT	FROM	TO	SIZE	PUT IN	PULLED OUT
Red Cave	Sandstone	1297	1304	4-1/2	1367	-0-

RECEIVED
STATE CORPORATION COMMISSION
DEC 31 1969
CONSERVATION DIVISION
Wichita, Kansas

Describe in detail the manner in which the well was plugged, indicating where the mud fluid was placed and the method or methods used in introducing it into the hole. If cement or other plugs were used, state the character of same and depth placed, from feet to feet for each plug set.

Spotted 15 sacks cement 1356'-1176', mud laden fluid 1176'-600',
15 sacks cement 600'-420', mud laden fluid 420'-65', 5 sacks
cement 65'-5'. Cut off & capped. No pipe recovery.

RECEIVED
STATE CORPORATION COMMISSION
DEC 24 1969
CONSERVATION DIVISION
Wichita, Kansas

(If additional description is necessary, use BACK of this sheet)

Name of Plugging Contractor Daco Lease & Well Service
Address 1700 S. Main, Borger, Texas 79007

STATE OF Texas, COUNTY OF Potter, ss.
Bob Conley (employee of owner) or (owner or operator) of the above-described well, being first duly sworn on oath, says: That I have knowledge of the facts, statements, and matters herein contained and the log of the above-described well as filed and that the same are true and correct. So help me God.

(Signature) Bob Conley
P.O. Box 911, Amarillo, Texas (Address)

SUBSCRIBED AND SWORN TO before me this 29th day of December, 1969

My commission expires June 1, 1971 Notary Public.

Government #2 (RC)
Section 17-34S-43W
Morton County, Kansas

RECEIVED
STATE CORPORATION COMMISSION
FEB 4 1970
CONSERVATION DIVISION
Wichita, Kansas

Driller's Log

<u>Depth</u>	<u>Formation</u>
0'-735'	Sand & Shale
735'-841'	Shale & Anhydrite
841'-1249'	Sand & Shale
1249'-1306'	Sand
1306'-1328'	Shale
PBTD -1328'	

Certificate:

I hereby certify the foregoing statements are true and correct to the best of my knowledge and belief.

Bob Conley
Bob Conley

Title: District Production Clerk

Subscribed and sworn to before me, a Notary Public, this 3rd day of February 1970.

Sharon E. Dawes
Notary Public

*My Commission Expires
June 1, 1971*