


STATE OF KANSAS
STATE CORPORATION COMMISSION

Give All Information Completely
Make Required Affidavit
Mail or Deliver Report to:
Conservation Division
State Corporation Commission
212 North Market, Insurance Bldg.
Wichita, Kansas

WELL PLUGGING RECORD

NORTH

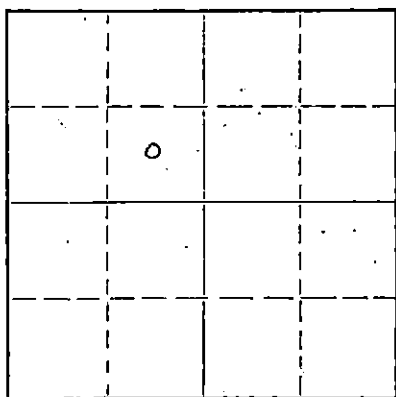

Locate well correctly on above
Section Plat

Seward County. Sec. 16 Twp. 34S Rge. 34 W (K) (W)
Location as "NE/CNW/SW" or footage from lines C-SE-NW Sec. 16
Lease Owner Hamilton Brothers, Ltd.
Lease Name Robert W. Baughman Well No. 1-16
Office Address 202 Vaughn Building, Amarillo, Texas
Character of Well (completed as Oil, Gas or Dry Hole) Dry Hole
Date well completed February 3 19 62
Application for plugging filed February 3 19 62
Application for plugging approved 19
Plugging commenced February 3 19 62
Plugging completed February 3 19 62
Reason for abandonment of well or producing formation Dry Hole

If a producing well is abandoned, date of last production None 19
Was permission obtained from the Conservation Division or its agents before plugging was commenced? Yes

Name of Conservation Agent who supervised plugging of this well W. L. Lackamp Jr.
Producing formation None Depth to top Bottom Total Depth of Well 6725 Feet
Show depth and thickness of all water, oil and gas formations.

OIL, GAS OR WATER RECORDS

CASING RECORD

FORMATION	CONTENT	FROM	TO	SIZE	PUT IN	PULLED OUT
				7 5/8"	2800	None

Describe in detail the manner in which the well was plugged, indicating where the mud fluid was placed and the method or methods used in introducing it into the hole. If cement or other plugs were used, state the character of same and depth placed, from feet to feet for each plug set.

Plug #1 2800-2600. 53 sx 16# Neat Cement

Drilling Mud 2600-600"

Plug #2 600' 528 - 20 sx 16# Neat Cement

Plug #3 35' - Surface 10 sx Neat Cement

RECEIVED
STATE CORPORATION COMMISSION
FEB 9 0 1962
2 20-62
CONSERVATION DIVISION
Wichita

(If additional description is necessary, use BACK of this sheet)

Name of Plugging Contractor Halliburton
Address Liberal, Kansas

STATE OF TEXAS, COUNTY OF POTTER, ss.
W. P. von Osinski (employee of owner) or (owner or operator) of the above-described


well, being first duly sworn on oath, says: That I have knowledge of the facts, statements, and matters herein contained and the log of the above-described well as filed and that the same are true and correct. So help me God.

(Signature) W. P. von Osinski

202 Vaughn Building, Amarillo, Texas
(Address)

SUBSCRIBED AND SWORN to before me this 16th day of February, 19 62.

My commission expires 6-1-63.

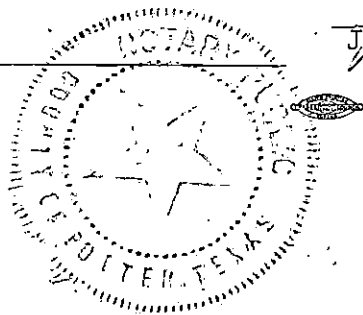

Jeannene Hart
Notary Public.

LEASE: Robt. W. Baughman No. 1-16

Location: C-SE-NW Sec. 16,

T-34S, R-34W,

OPERATOR: Hamilton Brothers, Inc.

Seward County, Kansas

CONTRACTOR: Carl B. King

Casing: 7 5/8" set @ 2800'

Commenced: 1-9-62

Completed: 2-3-62

Elevation: 2951 G.L.

Intermediate Casing	@	2800
Dolomite		2800 - 3030
Limestone		3030 - 3050
Grey Sandstone		3050 - 3070
Limestone		3070 - 3310
Grey - Brown Shale		3310 - 3360
Limestone		3360 - 3380
Sandstone and Grey Shale		3380 - 3410
Limestone		3410 - 3470
Grey Shale		3470 - 3480
Limestone		3480 - 3600
Grey Shale		3600 - 3630
Limestone		3630 - 3960
Grey Shale		3960 - 4030
Broken Lime and Grey Shale		4030 - 4500
Limestone		4500 - 4570
Limestone and Grey Shale		4570 - 4650
Limestone		4650 - 4750
Grey Shale		4750 - 4820
Limestone		4820 - 4900
Broken Limestone and Grey Shale		4900 - 5200
Limestone		5200 - 5400
Grey Shale		5400 - 5770
Limestone		5770 - 5810
Grey Shale w/Sdy Lime Stringers		5810 - 6110
Limestone w/Shale Stringers		6110 - 6250
Grey Shale - Some S S		6250 - 6380
Sandy Lime and Grey Shale		6380 - 6725
T.D.		6725

RECEIVED
FEB 10 1962
CONSERVATION DIVISION
WICHITA, KANSAS

STATE OF TEXAS
COUNTY OF POTTER

I hereby certify that the above is a true and correct copy of the log of the Robt. W. Baughman No. 1-16 Well, C-SE-NW Sec. 16-34S-34W, Seward County, Kansas.

Hamilton Brothers, Inc.

By: W. P. von Osinski
W. P. von Osinski, Geologist

Subscribed and sworn before me this 16th day of February, 1962.

Jeannene Hart
Notary Public

My Commission Expires 6-1-63

JEANNENE HART, Notary Public
Potter County, Texas